


Section 33 Township 14 Range 12-W

Well No. #1 Gray

Company Jones & Shelbourne

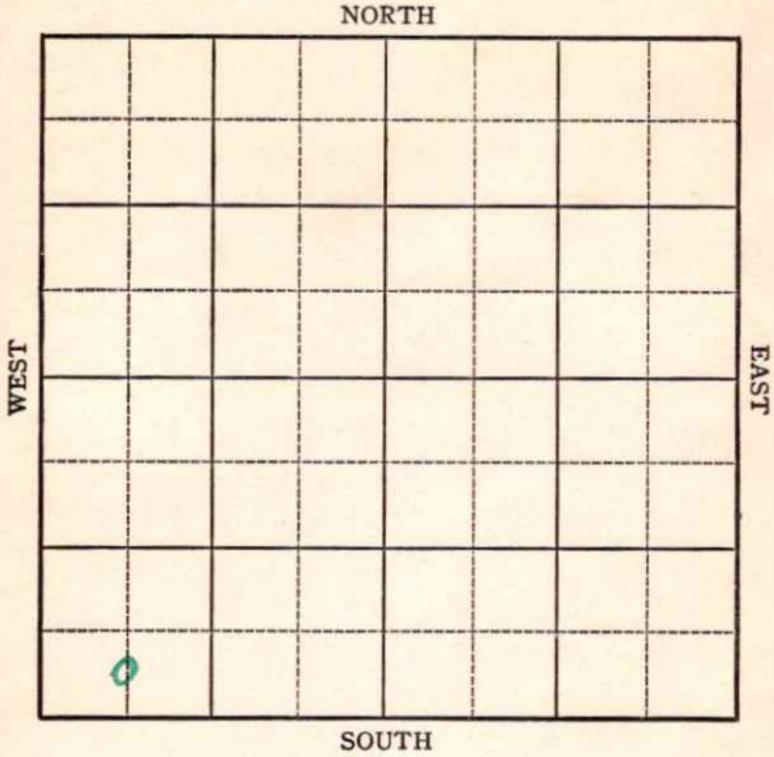

Sec. 33 Twp. 14 R. 12-W

Well No. #1 Gray Farm

Jones & Shelbourne Company


(Greenvale)

 Ft. from N. Line

330 Ft. from S. Line

 Ft. from E. Line

660 Ft. from W. Line

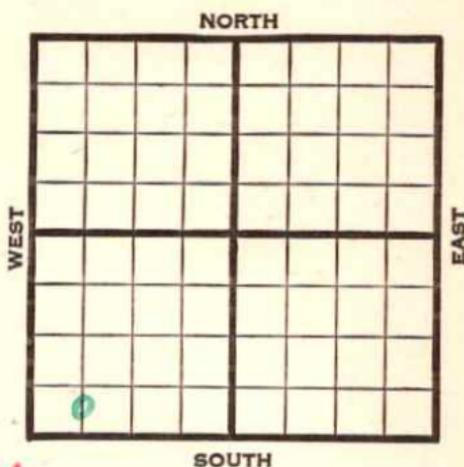

Elev. 1744

1942	REPORT
5/6	Cellar.
5/13	Rig.
5/20	20" - 43' 15" - 383' Drlg. 545'
5/27	Anhy. 649' 12" - 660' Drlg. 1580'
6/3	Drlg. 2350'
6/10	Dodge 2829' Drlg. 2875'
6/17	Lans. 2895' Pay 2978-83' T.D.
	26 bailers oil in 12 hours, Run 7".
6/24	Cong. 3189' Gorham 3197'
	T.D. 3212' 2½ bbls. oil per hour.
7/1	5" - 3197' WOC.
7/8	P.B.P.
7/15	"
7/22	P.B. to 3175' 69 shots 2982-96'
	13,000 acid. On potential.
7/29	To take pumping Pot.
	OVER

1942

8/5

Lans. 2895'

Gorham 3197'

5" - 3193'

PB 3175'

T.D. 3212'

69 shots 2982-96

13000 acid

Pump 656 Pot.

Gravity 38.5

COMPLETED

Russell

KANSAS

Map No. 556 Sec. 33 Twp. 14 R. 12WWell No. 1 GrayJones & Shelbourne Company**FIRST REPORT**

Contractor

C SL SW SW

SECTION PLAT

0			

 Ft. from N. Line330 Ft. from S. Line Ft. from E. Line660 Ft. from W. Line

GREENVALE POOL

Location Rig up

Drilling and Remarks:

Cellar

RECORD

Cased in., ft.Sand Gas Oil Total Depth

PRODUCTION

1st 24 hrs. Nat. 1st 24 hrs. after shot Gas Cu. Ft.Dry Hole Abandoned

Date

MAY 6 1942 19

S. J. LEWIS Scout

Russell

KANSAS

Map No. 56 Sec. 33 Twp. 14 R. 12WWell No. 1 GrayJones & Shelbourne CompanyCOMPLETED Contractor

C SL SW SW

SECTION PLAT

_____ Ft. from N. Line

330 Ft. from S. Line

_____ Ft. from E. Line

660 Ft. from W. LineGREENVALE POOL

Location _____

Rig up _____

Drilling and Remarks:


Date

RECORD

Cased _____ in., _____ ft.

Sand _____

Gas _____

Oil _____

Total Depth 3212

PRODUCTION

1st 24 hrs. Nat. _____

1st 24 hrs. after shot _____

Gas _____ Cu. Ft.

Dry Hole _____

Abandoned _____

AUG 5 1942 19 S. J. LEWIS Scout