

KANSAS


FORM 51 IOM 12-46 PETROL

McPherson

Section 8 Township 17 Range 1-W

Well No. #1 Lehman

Company Mid-Center Oil

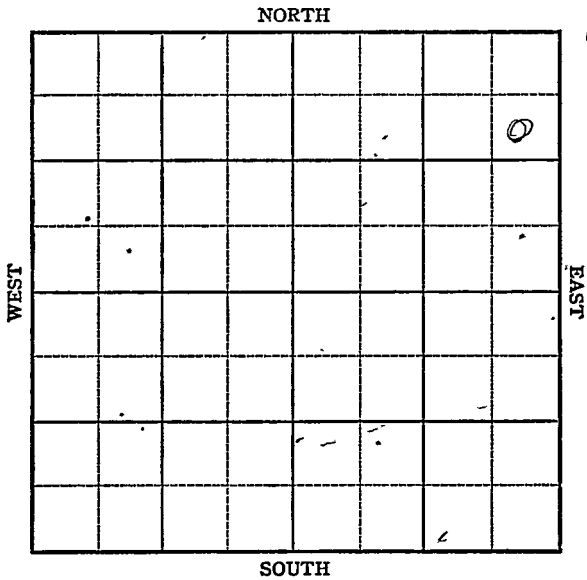

KANSAS

Henne Pool

Sec. 8 Twp. 17 R. 1-W


Well No. 1 Lehman Farm
Mid-Center Oil Company

990 NE/C
330 Ft. from N. Line

_____ Ft. from S. Line

330 Ft. from E. Line

_____ Ft. from W. Line

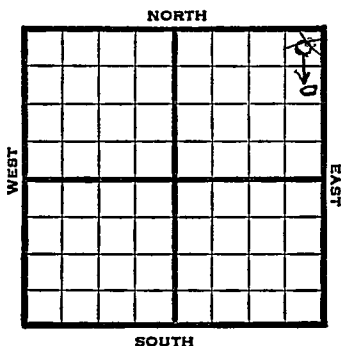

McPherson County

1947 ELEV. 1293 REPORT

2-12 R^{UR}

2/19 8" @ 160'

Drlg 1760'

2/26 Miss 2623
TD 2649 $\frac{1}{2}$ '

ABANDONED

Kans.
KANSASMap No. 42 Sec. 8 Twp. 17 R. 1WWell No. 1 LehmanMid-Center Oil CompanyFIRST REPORT Contractor

NE/C

SECTION PLAT

330 Ft. from N. Line Ft. from S. Line330 Ft. from E. Line Ft. from W. Line

McPherson County

Location Rig up

Drilling and Remarks:

R U R

RECORD

Cased in., ft.Sand Gas Oil Total Depth

PRODUCTION

1st 24 hrs. Nat. 1st 24 hrs. after shot Gas Cu. Ft.Dry Hole Abandoned

Date

FEB 12 1947 19 S. J. LEWIS Scout

Map No. 42 Sec. 8 Twp. 17 R. 1W

Well No. 1 Lehman


Mid-Center Oil _____ Company

CORRECTION

Contractor

SE NE NE

SECTION PLAT

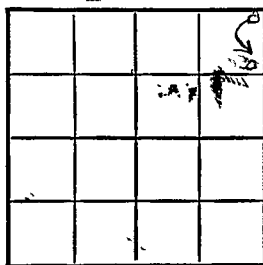

990 Ft. from N. Line

Ft. from S. Line

330 Ft. from E. Line

Ft. from W. Line

McPherson County

Location _____

Rig up _____

Drilling and Remarks:

Reported

NE/C

RECORD

Cased _____ in., _____ ft.

Sand _____

Gas _____

Oil _____

Total Depth _____

PRODUCTION

1st 24 hrs. Nat. _____

1st 24 hrs. after shot _____

Gas _____ Cu. Ft.

Dry Hole _____

Abandoned _____

Date

FEB 19 1947

19

S. J. LEWIS Scout

Map No. 42 Sec. 8 Twp. 17 R. 1W

Well No. 1 Lehman

Mid-Center Oil Company

ABANDONED

Contractor

SE NE NE

E/1288

SECTION PLAT

990 Ft. from N. Line

 Ft. from S. Line

330 Ft. from E. Line

 Ft. from W. Line

McPherson County

Location

Rig up

Drilling and Remarks:

Miss 2623

RECORD

Cased in., ft.

Sand

Gas

Oil

Total Depth 2649 1/2

PRODUCTION

1st 24 hrs. Nat.

1st 24 hrs. after shot

Gas Cu. Ft.

Dry Hole

Abandoned

Date

FEB 26 1947 19

S. J. LEWIS Scout