


Section 33 Township 14 Range 12-WWell No. #1 KejrCompany Cities Service oil

Greenvale pool

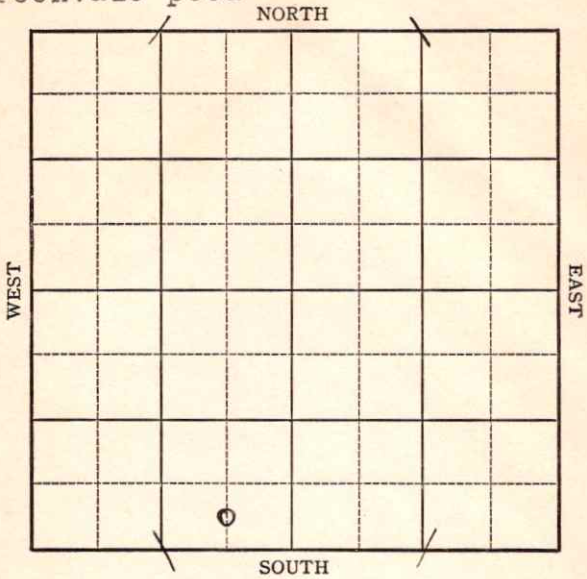

KANSAS

Russell


Sec. 33 Twp. 14 R. 12-WWell No. #1 Kejr FarmCities Service Oil Company

Greenvale pool

Ft. from N. Line

330 Ft. from S. Line660 Ft. from E. Line

Ft. from W. Line

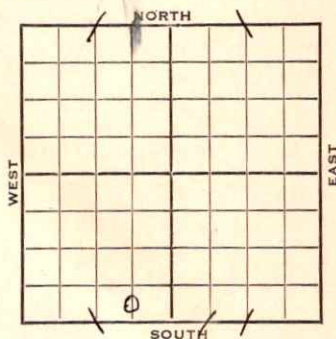

C SL SE SW

Elev. 1737

1942

REPORT

12/2 Pils

12/9 10" @ 337

Drlg. 1712

12/16 Drlg. 2980

12/22 **Lans 2894****Congl 3187****Gorham 3189**

TD 3210'

7" @ 3210' RUST SO

12/29 " " "

1943

1/6

6 shots 3148-89

24 shots 3184-87

Pump 45 oil & 120 water 13 hrs.

1/13 " " "

1/20 " " "

1/27 " " "

2/3 " " "

2/10 **Gorham 3185**

7" @ 3206'

T.D. 3206'

6 shots 3184-89

24 shots 3184-87

Pump 43 bbls oil plus 92 bbl water.

Gravity 38.2

COMPLETED

KANSAS

Map No. 56 Sec. 33 Twp. 14 R. 12WWell No. 1 Kejr

Cities Service Oil


Company

FIRST REPORT

Contractor

C SL SE SW

SECTION PLAT

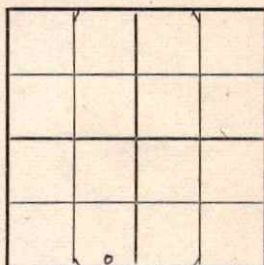

_____ Ft. from N. Line

330 Ft. from S. Line660 Ft. from E. Line

_____ Ft. from W. Line

GREENVALE POOL

Location _____

Rig up _____

Drilling and Remarks:

Pits

RECORD

Cased _____ in., _____ ft.

Sand _____

Gas _____

Oil _____

Total Depth _____

PRODUCTION

1st 24 hrs. Nat. _____

1st 24 hrs. after shot _____

Gas _____ Cu. Ft.

Dry Hole _____

Abandoned _____

Date

DEC 2 1942 19S. J. LEWIS

Scout

Russell


KANSAS

Map No. 56 Sec. 33 Twp. 14 R. 12WWell No. 1 KejrCities Service Oil CompanyCOMPLETED

Contractor

C SL SE SW

SECTION PLAT

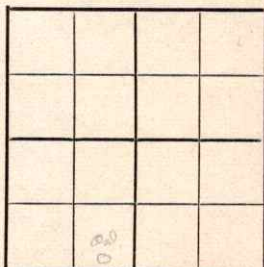 Ft. from N. Line330 Ft. from S. Line660 Ft. from E. Line Ft. from W. LineGREENVALE POOLLocation Rig up

Drilling and Remarks:

Got ran 3/857" @ 32066 1/2 hrs to 3184-8924 " 3184-82Pump 43 oil +92 water. 38 1/2 hr

RECORD

Cased in., ft.Sand Gas Oil Total Depth 3206

PRODUCTION

1st 24 hrs. Nat. 1st 24 hrs. after shot Gas Cu. Ft.Dry Hole Abandoned

Date

FEB 10 194319S. J. LEWIS

Scout