

KANSAS


Russell

FORM 51 5M 1-42 PETROL

Section 33 Township 14 Range 12W

Well No. #1 ~~#3~~ Ke JR

Company Jones & Shelbourne

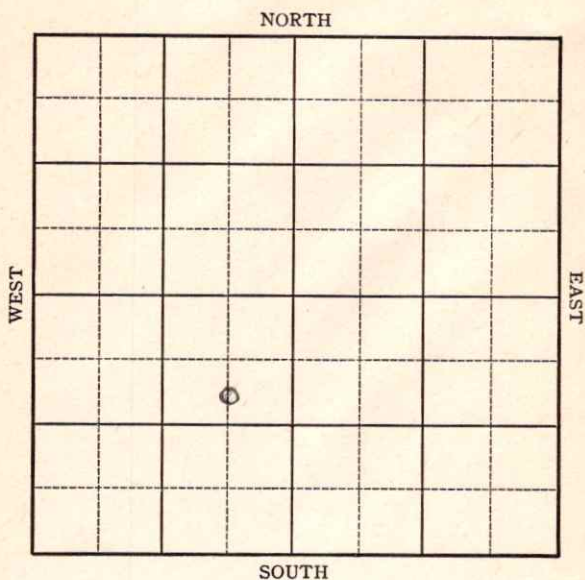

KANSAS


Sec. 33 Twp. 14 R. 12-W

Well No. #1 Kejr Farm

Jones & Schelbourne

Company

NORTH

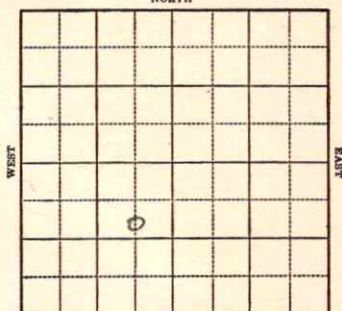

990 Ft. from N. Line

 Ft. from S. Line

660 Ft. from E. Line

 Ft. from W. Line

Elev. 1734

SOUTH

REPORT

1944

	Location
1/5	"
1-12	"
1/19	"
1/26	"
2/2	"
2/8	"
2/15	Spud
2/23	Anhy 633 13" @ 640 Drlg. 650
3/1	Drlg. +1730 50-80 -500 acid
3/8	10" @ 1935 & 12 water in 24 hrs. Drlg. 2330
3/16	8" @ 2540 Drilling 2810
3/22	Lans 2882 50-2892-97 8" @ 2899 Drlg. 2930
3/29	5" @ 2980 Drlg. 3130
4/5	5" @ 3145 Gorhan 3190 Drlg. 3208'

OVER

1944

4/12

HFW 3222-23 TD

5" @ 3120

WOC.

4/19

48 shots 3016-30 VSSO

4/26

Plug 3004-46 shots

2970-85 1000 oil in 12 hrs

4000 acid

5/3

5" @ 3120

Gorhan 3190

TD 3223

PB 33044

Lans 2882

46 shots 2970-85

4000 acid

Pump 790 Pot

Gravity 38

COMPLETED


KANSAS

Map No. 56 Sec. 33 Twp. 14 R. 12WWell No. 3 KejoJones & Shelbourne CompanyFIRST REPORT Contractor

C S L NE SW

990 Ft. from N. Line Ft. from S. Line660 Ft. from E. Line Ft. from W. Line

SECTION PLAT

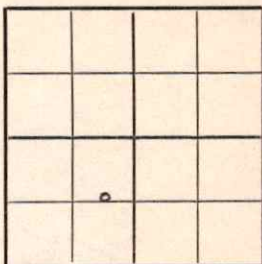

HALL-GURNEY POOL

Location XRig up

Drilling and Remarks:

RECORD

Cased in., ft.Sand Gas Oil Total Depth

PRODUCTION

1st 24 hrs. Nat. 1st 24 hrs. after shot Gas Cu. Ft.Dry Hole Abandoned

Date

JAN 5 1944 19S. J. LEWIS


Scout

KANSAS

Map No. 56 Sec. 33 Twp. 14 R. 12WWell No. 1 KejrJones & Shelbourne CompanyCORRECTION Contractor

C S L NE NW

SECTION PLAT

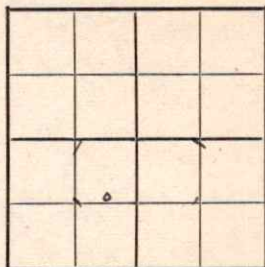990 Ft. from N. Line Ft. from S. Line660 Ft. from E. Line Ft. from W. Line

Hall-Gurney Pool

Location Rig up

Drilling and Remarks:

Reported as
#3 Kejr*Correct well #
From #3 to #1*

RECORD

Cased in., ft.Sand Gas Oil Total Depth

PRODUCTION

1st 24 hrs. Nat. 1st 24 hrs. after shot Gas Cu. Ft.Dry Hole Abandoned

Date

JAN 19 1911

19

S. J. LEWIS

Scout

KANSAS

Pool Name Hall-GurneyMap No. 56 Sec. 33 Twp. 14 R. 12WWell No. 1 KejrJones & Shelbourne Company

COMPLETED

Contractor

C S L NE SW

SECTION PLAT

990 Ft. from N. Line

Ft. from S. Line

660 Ft. from E. Line

Ft. from W. Line

Russell County

Location

Rig up

Drilling and Remarks:

Graham 31905" C 3/20P.B. 3004 Lane 288246 shot to 2970-854000 aciolPump 790 P.B.

Date

38°-42

RECORD

Cased _____ in., _____ ft.

Sand _____

Gas _____

Oil _____

Total Depth 3223

PRODUCTION

1st 24 hrs. Nat. _____

1st 24 hrs. after shot _____

Gas _____ Cu. Ft.

Dry Hole _____

Abandoned _____

MAY 3 1944S. J. LEWIS

Scout