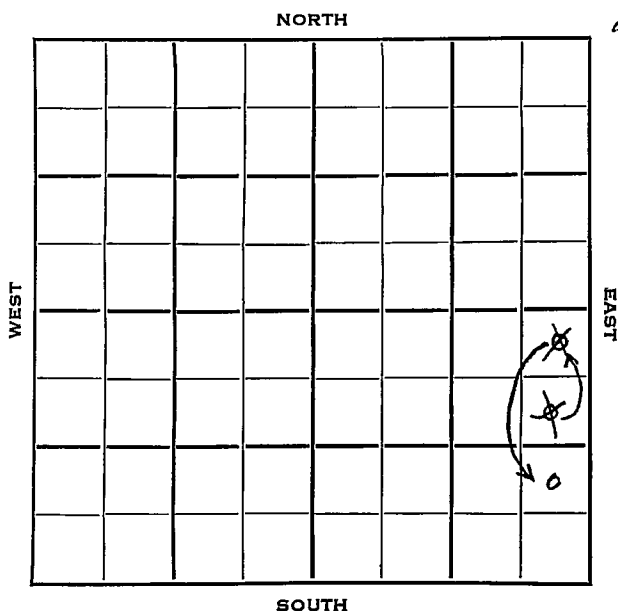


Section 8 Township 34 Range 3EWell No. 21 Baruth- (Baruth)Company L.C. Smitherman

Cowley **KANSAS** ✓

8

34

3E

Sec. _____ Twp. _____ R. _____

#2
#1 Baruth

Well No. _____ Farm _____

L. C. Smitherman

Company _____

Gaines

Baird Pool

Contractor _____

~~330~~
~~990~~

Ft. from N. Line


990

Ft. from S. Line

330

Ft. from E. Line

Ft. from W. Line

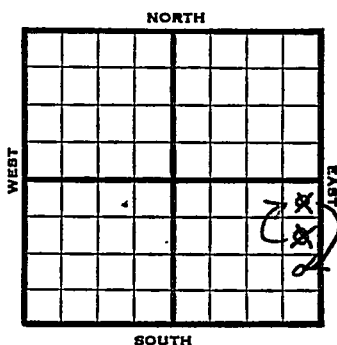~~SE NE SE~~
~~NE NE SE~~
~~NE SE SE~~

1953

Elev. -

REPORT

4/1

Spud 3-28-53

8" @ 72'

Drlg. 656'

5/20

Spud 3-28-53

Oil Well

TD 3308'

8" @ 72'

Stal. 2115, Layton 2595, KC 2755,

Oswego 2985

TD 3303'

5" @ 3303'

DD 3308 Miss 3303 Hydro.

Comp. 30 bopd.

COMPLETED

County Cowley State Kansas
 (Blk. (Sur.)
 Sec. 8 (Twp.) 34 (Rge.) 3E Map No.
 Operator L. C. Smitherman
 Well No. 1 Farm Baruth
 Elev. Location SE NE SE

FIRST REPORT

990 Ft. From N Line SE
330 Ft. From E Line Quarter
 Ist. Report APR 1 1953
 Completion
 Remarks
Gaines - Contr.
 Spudding Date 3-28-53

Drlg. Data Baird Pool
8" @ 72 drlg. 656

Map No. _____ Sec. 8 Twp. 34 R. 3EWell No. 1 Baruth_____
L. C. Smitherman Company

CORRECTION

Contractor

NE SE SE

SECTION PLAT

Ft. from N. Line990 Ft. from S. Line330 Ft. from E. Line_____
Ft. from W. Line

			o

Cowley County

Location _____

Rig up _____

Drilling and Remarks:

Recorrected
from
NE NE SE

RECORD

Cased _____ in., _____ ft.

Sand _____

Gas _____

Oil _____

Total Depth _____

PRODUCTION

1st 24 hrs. Nat. _____

1st 24 hrs. after shot _____

Gas _____ Cu. Ft.

Dry Hole _____

Abandoned _____

Date

APR 15 1953 19J. G. McGEHEE

Scout

Kansas

Map No. _____ Sec. 8 Twp. 34 R. 3EWell No. 1 BaruthL. C. Smitherman Company

CORRECTION

Contractor

NE NE SE


SECTION PLAT

330 Ft. from N. Line

_____ Ft. from S. Line

330 Ft. from E. Line

_____ Ft. from W. Line

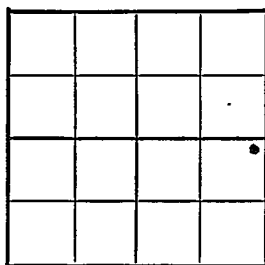

Cowley County

Location _____

Rig up _____

Drilling and Remarks:

Reported
SE NE SE

RECORD

Cased _____ in., _____ ft.

Sand _____

Gas _____

Oil _____

Total Depth _____

PRODUCTION

1st 24 hrs. Nat. _____

1st 24 hrs. after shot _____

Gas _____ Cu. Ft.

Dry Hole _____

Abandoned _____

Date

APR 8 1953 19

J. G. McGEHEE

Scout

Kansas

Map No. _____ Sec. 8 Twp. 34 R. 3EWell No. 2 Baruth_____L. C. Smitherman_____
CompanyCORRECTION
Contractor

NE SE SE

SECTION PLAT

_____Ft. from N. Line990 Ft. from S. Line330 Ft. from E. Line_____Ft. from W. Line

			o

Cowley County

Location _____

Rig up _____

Drilling and Remarks:

Reported

#1 Baruth

RECORD

Cased _____ in., _____ ft.

Sand _____

Gas _____

Oil _____

Total Depth _____

PRODUCTION

1st 24 hrs. Nat. _____

1st 24 hrs. after shot _____

Gas _____ Cu. Ft.

Dry Hole _____

Abandoned _____

Date


APR 29 1953

19

J. G. McGEHEE

Scout

County Cowley State Kansas
 Sec. 8 (Blk.) 34 (Sur.) 3E Map No.
 Operator L. C. Smitherman
 Well No. 2 Farm Baruth
 Elev. Location NE SE SE

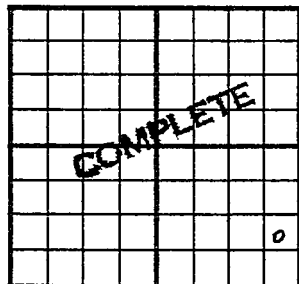

990 Ft. From S Line SE
330 Ft. From E Line Quarter
 1st. Report
 Completion MAY 20 1953
 Remarks Baird Pool
Gaines - Contr.
 Spudding Date 3-28-53

Drig. Data Oil well TD 3308
8" @ 72 Stal. 2115 Layton 2595
KC 2755 Oswego 2985 TD 3303 5" @ 3303
DD 3308 Miss. 3303 Hydro.
Comp. 30 hord

J. G. MCGEEHEE