



Russell

KANSAS

Sec. 7 Twp. 14 R. 13W

Well No. #2 ~~#3~~ Ehrlich "B" Farm

Jayhawk Well Service Company

Jayhawk Contractor


Ft. from N. Line

330 Ft. from S. Line

Ft. from E. Line

990 Ft. from W. Line

SE SW SE

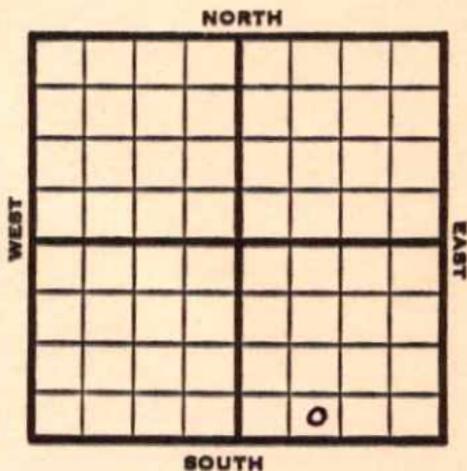

1953

REPORT

6/10

C & P

6/24

8" @ 336

Drlg.

7/1

1st Tarkio 2358, 2nd Tarkio 2380

Drlg.

7/8

N.R.

7/15

Spud 6-12-53 Oil well TD 2396

8" @ 336 1st Tarkio 2358

2nd Tarkio 2380 TD 2396 5" @ 2396

22/2358-65 S/6 GO 5 GWPH Sd-frac

S/6 BO 6 BWPH

Comp. 25 BOPD 25 BW

COMPLETED





Map No. \_\_\_\_\_ Sec. 7 Twp. 14 R. 13WWell No. 2 Ehrlich "B"Jayhawk Well Servicing CompanyCORRECTION

Contractor

SE SW SE

## SECTION PLAT

\_\_\_\_\_ Ft. from N. Line

330 Ft. from S. Line

\_\_\_\_\_ Ft. from E. Line

990 Ft. from W. Line

|  |  |  |   |
|--|--|--|---|
|  |  |  |   |
|  |  |  |   |
|  |  |  |   |
|  |  |  | o |

Russell County

Location \_\_\_\_\_

Rig up \_\_\_\_\_

Drilling and Remarks:

Reported

#3 Ehrlich

## RECORD

Cased \_\_\_\_\_ in., \_\_\_\_\_ ft.

Sand \_\_\_\_\_

Gas \_\_\_\_\_

Oil \_\_\_\_\_

Total Depth \_\_\_\_\_

## PRODUCTION

1st 24 hrs. Nat. \_\_\_\_\_

1st 24 hrs. after shot \_\_\_\_\_

Gas \_\_\_\_\_ Cu. Ft.

Dry Hole \_\_\_\_\_

Abandoned \_\_\_\_\_

Date

JUN 17 1953 19J. G. McGEHEE

Scout