


Section 8 Township 34 Range 3E

Well No. #1 Baruth (*Bahruth*)

Company C R A

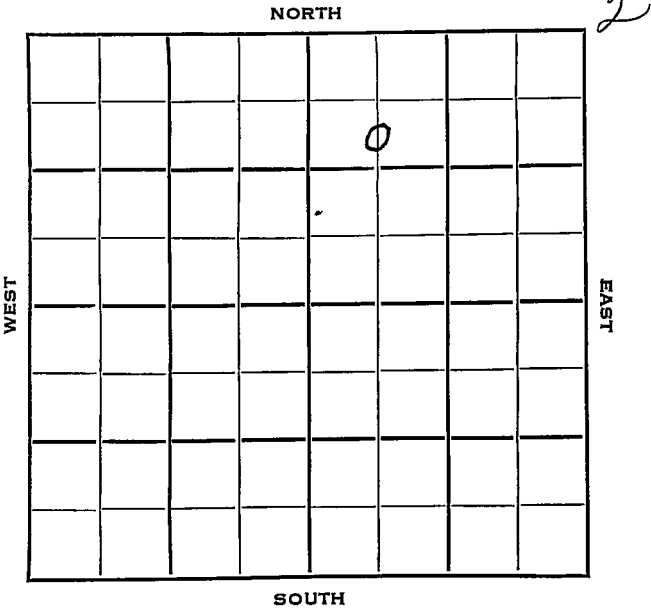

Cowley KANSAS

8

34

3E

Sec. _____ Twp. _____ R. _____

Well No. #4 Baruth Farm

C R A

Company

Gaines Drlg.

Contractor

Gueda Springs Pool

990

Ft. from N. Line


Ft. from S. Line

Ft. from E. Line

660

Ft. from W. Line

C S L NW NE

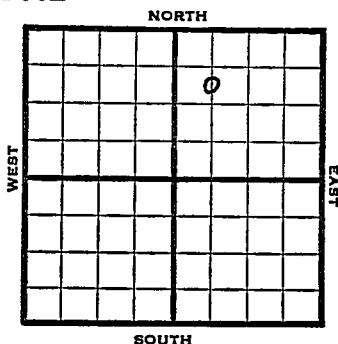

1953

Elev. 1089' REPORT

5/6

7/1

MIR

spud 5-6-53

Oil Well

TD 3315'

8" @ 75'

Layton 2599, KC 2780, Bart 3290, Miss 3314

TD 3315'

5" @ 3314'

CO to 3308 24/ 3293-3301 6 1/2 gm &

SSO 17/ 3287-93 B/ mud & sso

sd-frac S/ 116 1/2 bo 39 bw 20 hr.

Comp. 52 bopd 28 bw.

COMPLETED

County Cowley State Kansas

Sec. 8 (Blk.) 34 (Sur.) 3E Map No.

Operator **CRA**

Well No. 4 Farm Baruth

Elev.	Location	C	S	T.	NW	NE
-------	----------	---	---	----	----	----

990 Ft. From N Line NHE

660 Ft. From ~~W~~ Line Quarter

1st. Report MAY 6 1953

Completion

Remarks


Gaines Drlg. - Contr.

Spudding Date _____

Drlg. Data Gueda Springs Pool

HIR

J. G. McGEHEE

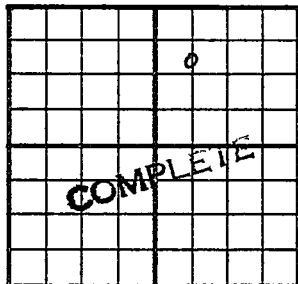County Cowley State KansasSec. 8 (Blk. Twp.) 34 (Sur. Rge.) 3E Map No. _____Operator C R AWell No. 4 Farm BaruthElev. 1089 Location C S L NW NE -990 Ft. From N Line NE660 Ft. From W Line Quarter1st. ReportCompletion JUL 1 1953Remarks Gudda Springs PoolGaines Drlg. - Contr.Spudding Date 5-6-53Drlg. Data Oil well TD 33158" @ 75 Layton 2599 KC 2780Bart. 3290 Miss. 3314 TD 33155" @ 3314 CO to 3308 24/ 3293-33016 1/2" gm & SSO 17/ 3287-93 B/ mud & so3 1/2" frac S/ 116 1/2 bo 39 bw 20 hr.Comp. 52 bopd 28 bw