KANSAS


Form 51—5M—4-36—Palace

Ellis

Section 26 Township 14 Range 19-W

Well Number #1 Copeland

Company Derby Oil

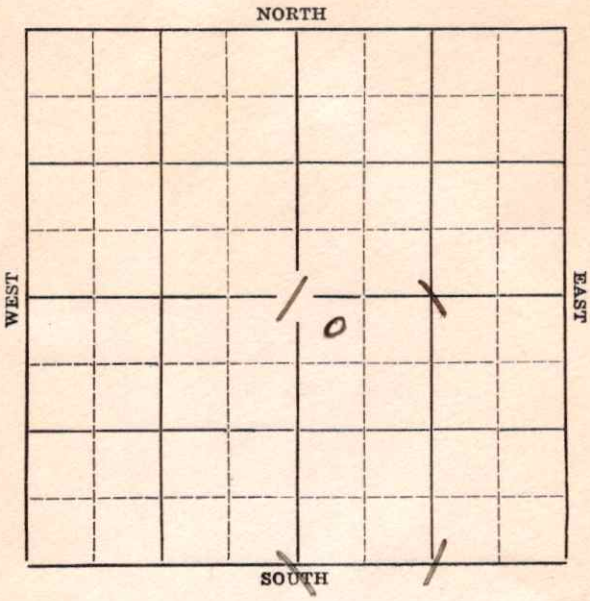

Form 252-A—5M—7-36—Palace KANSAS Ellis

Sec. 26 Twp. 14 R. 19W

Well No. #1 Copeland Farm


Derby Oil Company

330' Ft. from N. Line

_____ Ft. from S. Line

_____ Ft. from E. Line

330' Ft. from W. Line

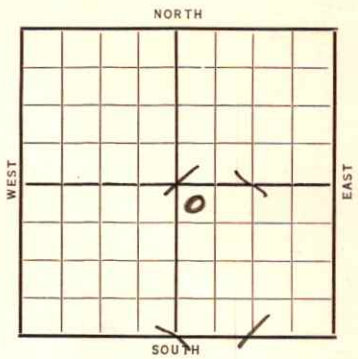

Elev. 2086

Date 1936	REPORT
10/7	Rig.
10/15	Rigging up.
10/22	15" @ 35'. 10" @ 1050'. Drlg.
10/29	Anhydrate 1350'. Drlg. 1365'.
11/6	Drlg. 2420
11/12	Drlg. 3375
11/19	Sil. 3743 set 7" Rust.
11/25	Sil. 3743'. Basil Sd. 3774'.
	T. D. 3795'. HFW. D & A
	ABANDONED

Form 26—1M Bks.—2-29

KANSAS


Map No. 70 Sec. 26 Twp. 14 R. 19W

Well No. 1 Copeland

Derby Oil Company

Contractor

SECTION PLAT

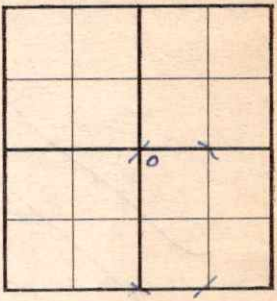

330 Ft. from N. Line

_____ Ft. from S. Line

_____ Ft. from E. Line

330 Ft. from W. Line

FIRST REPORT

Location _____

Rig up _____

Drilling and Remarks:

Rig

RECORD

Cased _____ in., _____ ft.

Sand _____

Gas _____

Oil _____

Total Depth _____

PRODUCTION

1st 24 hrs. Nat. _____

1st 24 hrs. after shot _____

Gas _____ Cu. Ft.

Dry Hole _____

Abandoned _____

Date

OCT 7 1936 19

S. J. Lewis Scout

Form 26-1M Bks.—2-29 KANSAS


Map No. 70 Sec. 26 Twp. 14 R. 19W

Well No. 1 Copeland

Derby. Company

Contractor

SECTION PLAT

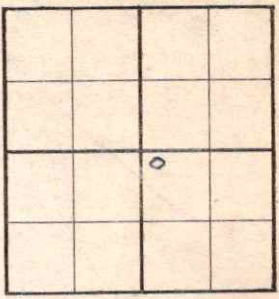

330 Ft. from N. Line

_____ Ft. from S. Line

_____ Ft. from E. Line

330 Ft. from W. Line

ABANDONED

Location _____

Rig up _____

Drilling and Remarks:

Sil 3743

Basil Sol 3774

HFW

D&A

RECORD

Cased _____ in., _____ ft.

Sand _____

Gas _____

Oil _____

Total Depth 3795

PRODUCTION

1st 24 hrs. Nat. _____

1st 24 hrs. after shot _____

Gas _____ Cu. Ft.

Dry Hole _____

Abandoned _____

Date

NOV 25 1936

19 S. J. LEWIS Scout