


Map No. KANSAS Sec. 26 Twp. 14 R. 19WWell No. #1 Copeland FarmTwin Drilling et al. Company

NORTH

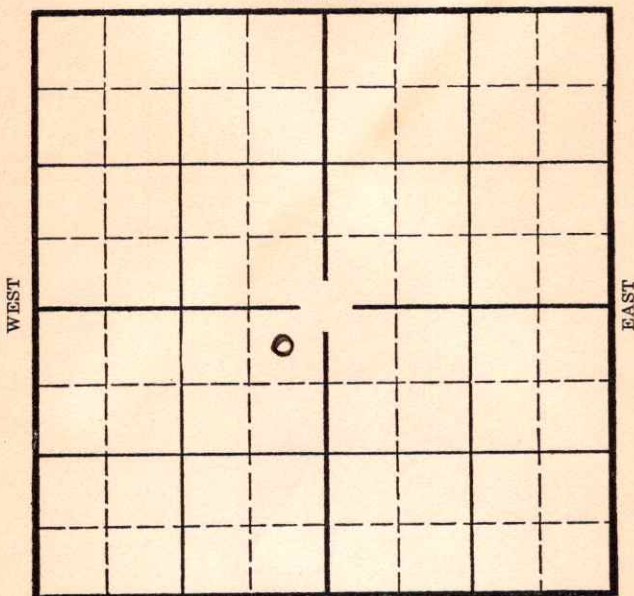

SOUTH

Location _____

Drilling Remarks _____

Rig Up _____

Drilling Remarks _____

RECORD

Cased _____ in. _____ ft.

Sand _____

Gas _____

Oil _____

Total Depth _____

PRODUCTION

1st 24 hrs. Nat. _____

1st 24 hrs. after shot _____

Gas _____ cu. ft.

Dry Hole _____

Abandoned _____

KANSAS

Map No. _____ Sec. 26 Twp. 14 R. 19-W

Well No. 1-Copeland _____ Farm

Twin Drilling et al _____ Company


330 Ft. from N. Line

_____ Ft. from S. Line

330 Ft. from E. Line

_____ Ft. from W. Line

Elev. 2082

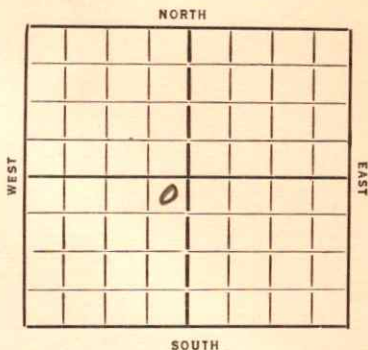Date
1936

REPORT

4/8 Moving in

4/16 Rig.

4/23 -- 4/30 --

5/7 Drlg. 1075'.

5/14 No report.

5/21 Drlg. 2305'.

5/28 Drlg. 3100'.

6/4 Oswald 3397'. S.O. 3399'. Water 3413
3422-33'. Drlg. 3485'.6/11 7" @ 3703'. Core 3690-3710'. T.D.
(6/18) SAND 3704-10 - 2115' Oil/Water
Sand 3704-09'. 34 Gravity

6/22 Pumping 15 bbls. per hour (Tel)

6/24/36-Sand Regan 3704'.

T.D. 3710'.

Pump 410 bbls.

COMPLETED

KANSAS

Map No. 70 Sec. 26 Twp. 14 R. 19WWell No. 1 CopelandTwin Drilling & Oil Company

Contractor

SECTION PLAT

230 Ft. from N. Line

Ft. from S. Line

230 Ft. from E. Line

Ft. from W. Line

	0		

FIRST REPORT

Location

Rig up

Drilling and Remarks:

Hoisting in

RECORD

Cased.....in.,ft.

Sand.....

Gas.....

Oil.....

Total Depth.....

PRODUCTION

1st 24 hrs. Nat.....

1st 24 hrs. after shot.....

Gas.....Cu. Ft.

Dry Hole.....

Abandoned.....

Date

4/5/26 192.....

S. J. LEWIS

Scout

KANSAS

Map No. 70 Sec. 26 Twp. 14 R. 19WWell No. 1 OpeelandTwin Trig & Co Company

Contractor

SECTION PLAT

330 Ft. from N. Line

_____ Ft. from S. Line

330 Ft. from E. Line

_____ Ft. from W. Line

COMPLETED

	0		

Location _____

Rig up _____

Drilling and Remarks:

Sand Regan.3704Pump #10

RECORD

Cased _____ in., _____ ft.

Sand _____

Gas _____

Oil _____

Total Depth 3710

PRODUCTION

1st 24 hrs. Nat. _____

1st 24 hrs. after shot _____

Gas _____ Cu. Ft.

Dry Hole _____

Abandoned _____

Date

JUN 24 1936

19

S. J. LEWIS Scout