


Section 8 Township 34 Range 3E

Well No. 2 - Dunlap "A"

Company Laura Jane Oil

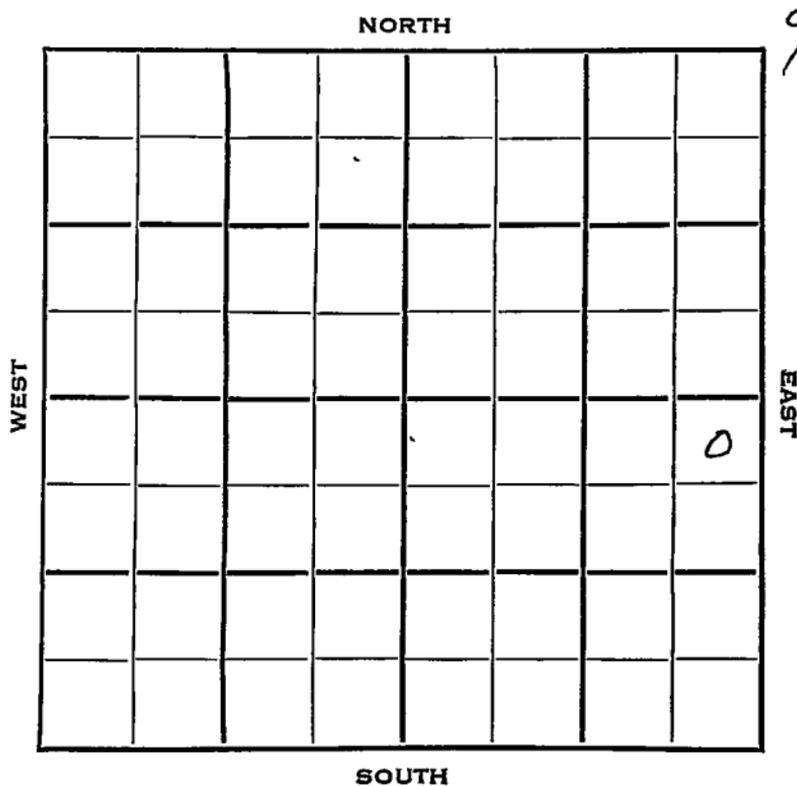

Cowley KANSAS ✓

Sec. 8 Twp. 34 R. 3 III

Well No. # 2 Dunlap "A" Farm

Laura Jane Oil Company

Laura Jane Contractor


330 Ft. from N. Line

_____ Ft. from S. Line

330 Ft. from E. Line

_____ Ft. from W. Line

NE NE SE

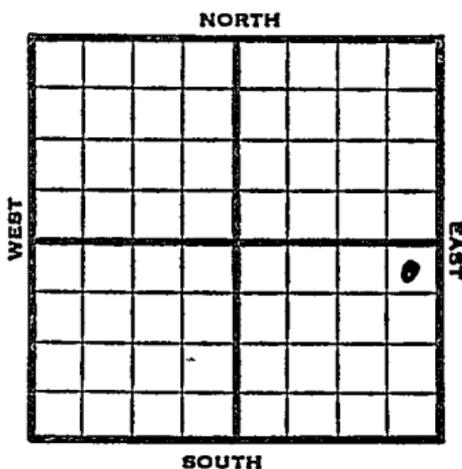

1953

Elev. 1087' REPORT

1/21
3/4

RUR

Spud 1-21-53

Oil Well

TD 3338

8" @ 89

Stal 2160, Layton 2588, KC

2774, Peru 2912, Marm 2962,

Oswego 2983, Miss 3308

DST 3315-38, opn 1 hr., gas

in 20 mins., rec. 100' o & gcm,

90' gassy oil, 60' wtr 940#

TD 3338

5" @ 3317

CO to 3338

Hydro

4 boph

Comp. 50 bopd 30% wtr.

COMPLETED

County Cowley State Kansas

Sec. 8 (Blk. Twp.) 34 (Sur. Rge.) 3E Map No.

Operator Laura Jane Oil

Well No. 2 Farm Dunlap "A"

Elev. Location NE NE SE

330 Ft. From N Line SE

330 Ft. From E Line Quarter

1st. Report JAN 21 1953

Completion

Remarks

Laura Jane - Contr.

Spudding Date

Drlg. Data

RUR

