FORM 51 25M 3-49 PETROL

KANSAS


Ellis

Section 26 Township 14 Range 19W

Well No. 1 Copeland

Company Western Royalty

Antonio

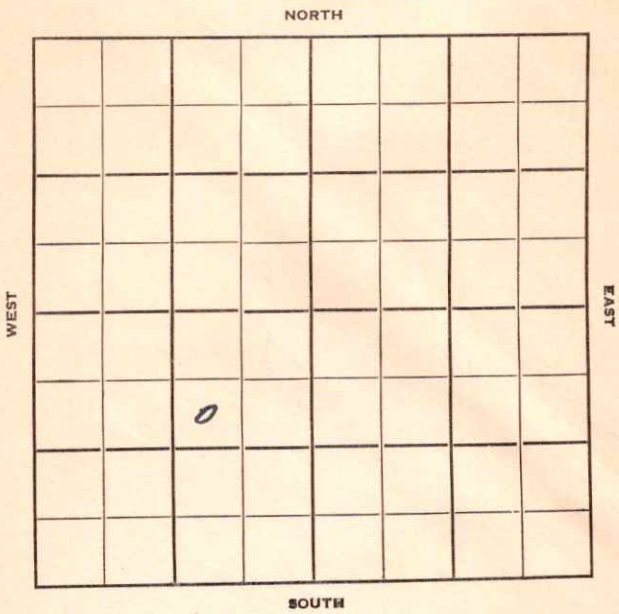

FORM 252-A
5M 10-48 PETROL

Ellis KANSAS

Sec. 26 Twp. 14 R. 19W

Well No. #1 Copeland Farm

Western Royalty Company

Antonio Pool (Glen Nye, Cont.)


990' Ft. from N. Line

Ft. from S. Line

990' Ft. from E. Line

Ft. from W. Line

SW NE SW

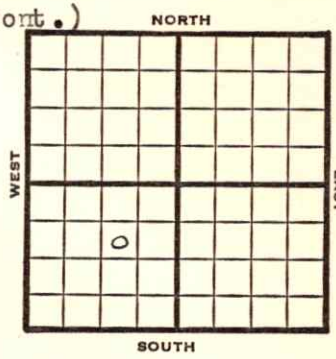

1949	Elev 2078' REPORT
6/29	8" @ 221' Anhy. 1340' Drlg. 1973'
7/6	Lansing 3392' Drlg. 3560'
7/13	TD 3750' Arb. 3744' Aband. ABANDONED

Form 26 200 Bks. 6-49 Petrol

Kansas

Antonio Pool

Map No. _____ Sec. 26 Twp. 14 R. 19W

Well No. 1 Copeland


Western Royalty Company

Glen Nye Contractor

SW NE SW

FIRST REPORT

SECTION PLAT

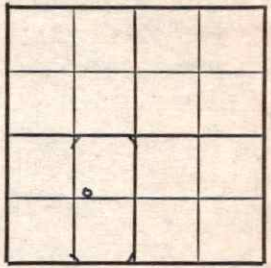

990 Ft. from N. Line

_____ Ft. from S. Line

990 Ft. from E. Line

_____ Ft. from W. Line

Ellis County

Location _____

Rig up _____

Drilling and Remarks:

8" @ 221

Anny 1340

drlg. 1973

RECORD

Cased _____ in., _____ ft.

Sand _____

Gas _____

Oil _____

Total Depth _____

PRODUCTION

1st 24 hrs. Nat. _____

1st 24 hrs. after shot _____

Gas _____ Cu. Ft.

Dry Hole _____

Abandoned _____

Date

JUN 29 1949 19

S. J. LEWIS Scout

Form 26 200 Bks. 9-48 Petrol

Kansas

Antonio Pool

Map No. K 70 Sec. 26 Twp. 14 R. 19W

Well No. 1 Copeland

Western Royalty Company

ABANDONED Contractor

SW NE SW

990 Ft. from N. Line

Ft. from S. Line


990 Ft. from E. Line

Ft. from W. Line

Ellis County

E 1,2078.

SECTION PLAT

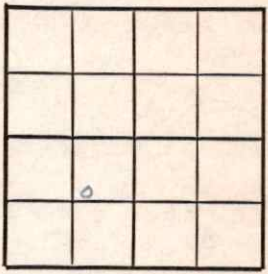

Location

Rig up

Drilling and Remarks:

Cu #3744

RECORD

Cased in., ft.

Sand

Gas

Oil

Total Depth 3250

PRODUCTION

1st 24 hrs. Nat.

1st 24 hrs. after shot

Gas Cu. Ft.

Dry Hole

Abandoned

Date

JUL 13 1949 19

S. J. LEWIS Scout