


Section 8 Township 34 Range 3-E

Well No. #1 Bayruth "A" (Bahruth)

Company Greeley Drlg.

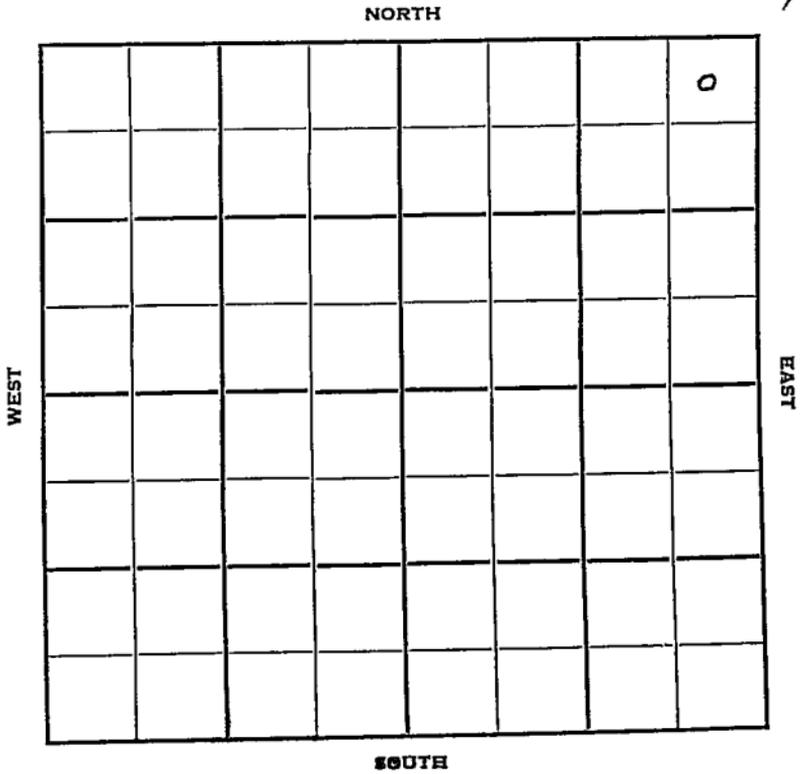

Sec. 8 Twp. 34 R. 3-E

Well No. #1 Bayruth "A" Farm

Greenley Drlg Company

Greeley Drlg Contractor


330 Ft. from N. Line

_____ Ft. from S. Line

330 Ft. from E. Line

_____ Ft. from W. Line

NE NE NE

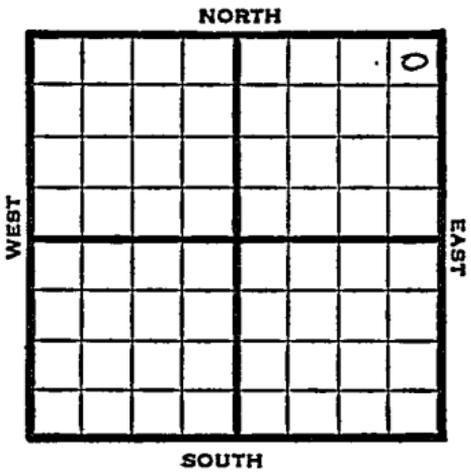

1950 Elev 1089 REPORT

5/17 Spud 5-13-50
8" @ 93'
Drlg 941'

5/31 8" @ 93'
Bart 3270
TD 3410
D&A
ABANDONED

Miss 3314

Map No. _____ Sec. 8 Twp. 34 R. 3E

Well No. 1 Baynath (A)

Greeley Drlg. Company

Greeley Drlg. Contractor

NE NE NE

SECTION PLAT

330 Ft. from N. Line

_____ Ft. from S. Line

330 Ft. from E. Line

_____ Ft. from W. Line

			o
FIRST REPORT			

Cowley

Location _____

Rig up _____

Drilling and Remarks:

Spud 5-13-50

8" @ 93

Drlg. 941

RECORD

Cased _____ in., _____ ft.

Sand _____

Gas _____

Oil _____

Total Depth _____

PRODUCTION

1st 24 hrs. Nat. _____

1st 24 hrs. after shot _____

Gas _____ Cu. Ft.

Dry Hole _____

Abandoned _____

Date

MAY 17 1950

J. E. TYRA Scout

DAHS28

Map No. _____ Sec. 8 Twp. 34 R. 3E

Well No. 1 Bayruth (A)

Greeley Drlg. Company _____

Contractor _____
NE NE NE

EI. 1089
SECTION PLAT

330 Ft. from N. Line

_____ Ft. from S. Line

330 Ft. from E. Line

_____ Ft. from W. Line

			0
ABANDONED			

Cowley

Location _____

Rig up _____

Drilling and Remarks:

8" C 93
Bar. 3270
Miss 3314
T.D. 3410
D & A

RECORD

Cased _____ in., _____ ft.

Sand _____

Gas _____

Oil _____

Total Depth 3410

PRODUCTION

1st 24 hrs. Nat. _____

1st 24 hrs. after shot _____

Gas _____ Cu. Ft.

Dry Hole _____

Abandoned _____

Date

MAY 31 1950

J. E. TYR Scout