


Map No. KANSAS Sec. 8 Twp. 34 R. 3E

Well No. #1 Dunlap Farm _____
Shawver et al Company _____

NORTH

7

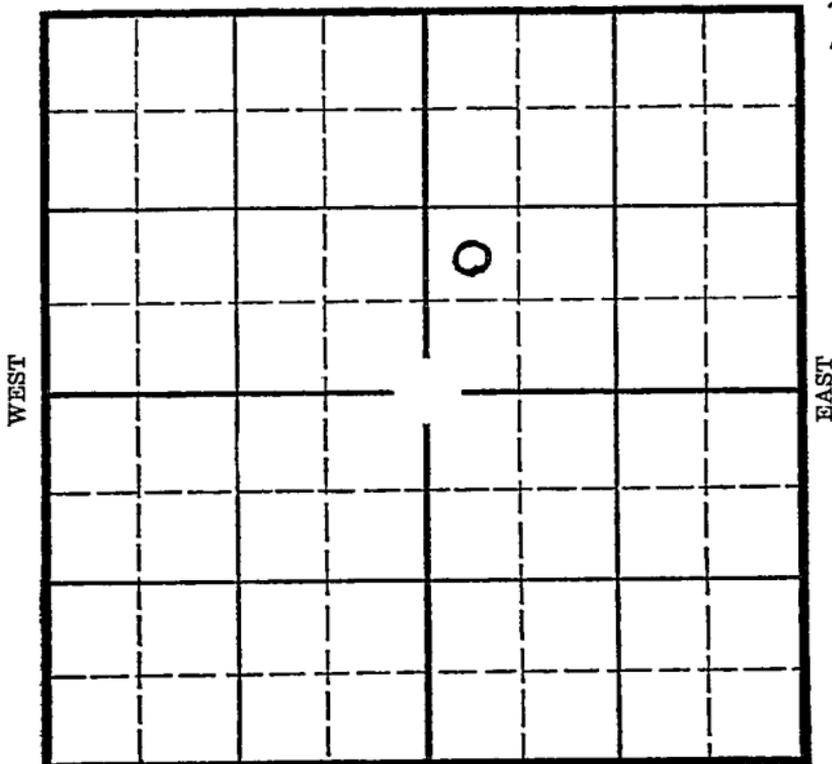

SOUTH

Location _____

Drilling Remarks _____

Rig Up _____

Drilling Remarks _____

RECORD

Cased _____ in. _____ ft.

Sand _____

Gas _____

Oil _____

Total Depth _____

PRODUCTION

1st 24 hrs. Nat. _____

1st 24 hrs. after shot _____

Gas _____ cu. ft. _____

Dry Hole _____

Abandoned _____

Map No. _____ Sec. 8 Twp. 34 R. 3-E

Well No. 1-Dunlap Farm _____

Shawyer et al Company _____


_____ Ft. from N. Line

990 Ft. from S. Line

_____ Ft. from E. Line

330 Ft. from W. Line

Elev. 1090

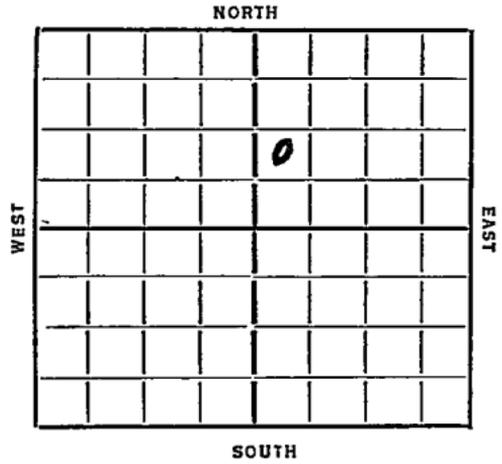

Date
1936

REPORT

4/8 R.O.G.

4/16 Rig.

4/23 --

4/30 Drlg. 730'.

5/7 Drlg. 1065'.

5/14 Drlg. 1904'.

5/21 Drlg. 2164'.

5/28 Drlg. 2455'.

6/4 Drlg. 2769'.

6/11 Drlg. 3269'.

6/18 Chat 3226': 10 qts. 1600' of oil.

6/25 Cleaning out.

7/2 Shut down.

7/9 -- 7/16 --

7/23 5" @ 3279'.

7/30 Shut down.

8/5/36-Chat 3326'.

TD 3335'. Shot 10 qts.

Estimate 50 bbls.

COMPLETED

Map No. 11 Sec. 8 Twp. 34 R. 3E

Well No. 1 Thunlap

Shawver & Co Company

Contractor

SECTION PLAT

		0	

.....Ft. from N. Line

990 Ft. from S. Line

.....Ft. from E. Line

000 Ft. from W. Line

FIRST REPORT

Location.....

Rig up.....

Drilling and Remarks:

RDG

RECORD

Cased.....in.,ft.

Sand.....

Gas.....

Oil.....

Total Depth.....

PRODUCTION

1st 24 hrs. Nat.....

1st 24 hrs. after shot.....

Gas.....Cu. Ft.

Dry Hole.....

Abandoned.....

Date

4/8/36 192.....

S. J. [Signature]

Scout

KANSAS

Cowley
 Map No. 7 Sec. 8 Twp. 34 R. 3E

Well No. 1. Dunlap

Shawver & Co. Company

Contractor

SECTION PLAT

		0	

_____ Ft. from N. Line

990 Ft. from S. Line

_____ Ft. from E. Line

320 Ft. from W. Line

COMPLETED

Location _____

Rig up _____

Drilling and Remarks:

*@ hat 3326.
 Shot 109 ts.
 Est 50 8 1/2*

RECORD

Cased _____ in., _____ ft.

Sand _____

Gas _____

Oil _____

Total Depth 3835

PRODUCTION

1st 24 hrs. Nat. _____

1st 24 hrs. after shot _____

Gas _____ Cu. Ft.

Dry Hole _____

Abandoned _____

Date

AUG 5 1936 19

S. J. LEWIS

Scout