


Section 6 Township 13 Range 20-W

Well No. #3 Bittel "B"

Company Derby

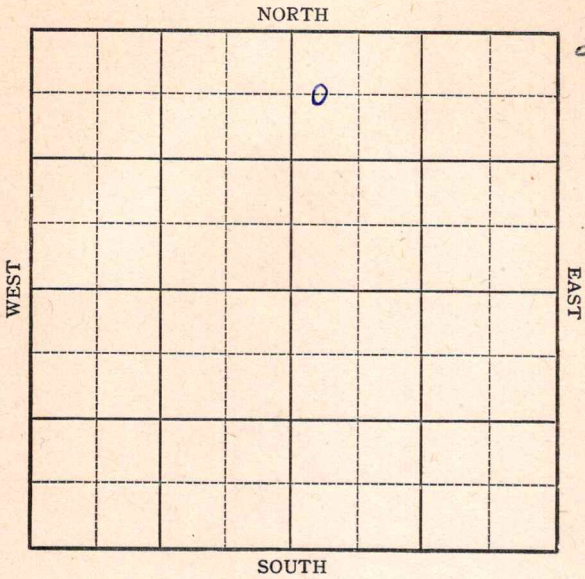


Sec. 6 Twp. 13 R. 20-W

Well No. #3 Bittel "B" Farm \_\_\_\_\_

Darby Company \_\_\_\_\_

NORTH

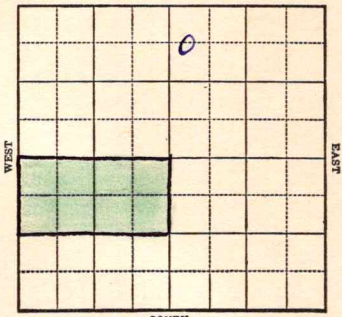

SOUTH

660 Ft. from N. Line  
 \_\_\_\_\_ Ft. from S. Line  
 \_\_\_\_\_ Ft. from E. Line  
330 Ft. from W. Line

1943

R E P O R T

10/6 Rotary  
 10/13 10" @ 119'  
       **Anhy 1530'**  
       Drlg. 2403'  
 10/20 **Cong 3804'**  
       **Sand 3823-29 Sat.**  
       **Arb. 3829-32 T.D.**  
       Run Csg.  
 10/27 **Topeka 2785**  
       **Lans 3069**  
       7" @ 3072  
       Drlg. 3321  
 11/3 **Arb 3826**  
       7" @ 3826  
       Pump 247 Pot.  
       T.D. 3827'  
       Gravity 36

**COMPLETED**

KANSAS

Map No. 70 Sec. 6 Twp. 13 R. 20W

Well No. 3 Bittel "B"

Darby

Company

FIRST REPORT

Contractor

C W L NW NE

SECTION PLAT

660 Ft. from N. Line

Ft. from S. Line

Ft. from E. Line

330 Ft. from W. Line

		o	

Ellis Pool

Location

Rig up

Drilling and Remarks:

Rotary

RECORD

Cased in., ft.

Sand

Gas

Oil

Total Depth

PRODUCTION

1st 24 hrs. Nat.

1st 24 hrs. after shot

Gas Cu. Ft.

Dry Hole

Abandoned

Date

OCT 6 1943 19

S. J. LEWIS Scout

~~KANSAS~~  
 Map No. \_\_\_\_\_ Sec. 6 Twp. 13 R. 20W

Well No. 3 Bittel "B"

Darby Company

**COMPLETED**

Contractor \_\_\_\_\_

C W L N W N E

660 Ft. from N. Line

\_\_\_\_\_ Ft. from S. Line

\_\_\_\_\_ Ft. from E. Line

330 Ft. from W. Line

**SECTION PLAT**

		D	

Ellis Pool

Location \_\_\_\_\_

Rig up \_\_\_\_\_

Drilling and Remarks:

*Cor 43826*

*7" @ 3826*

*Pump 247 P.J.*

*360 - 3/4*

**RECORD**

Cased \_\_\_\_\_ in., \_\_\_\_\_ ft.

Sand \_\_\_\_\_

Gas \_\_\_\_\_

Oil \_\_\_\_\_

Total Depth 3847

**PRODUCTION**

1st 24 hrs. Nat. \_\_\_\_\_

1st 24 hrs. after shot \_\_\_\_\_

Gas \_\_\_\_\_ Cu. Ft.

Dry Hole \_\_\_\_\_

Abandoned \_\_\_\_\_

Date

NOV 3 1943 19

S. J. LEWIS Scout