


SECTION 28 TOWNSHIP 14 RANGE 19W

WELL NO. #1 Feitz "B"

COMPANY Walters Drlg.

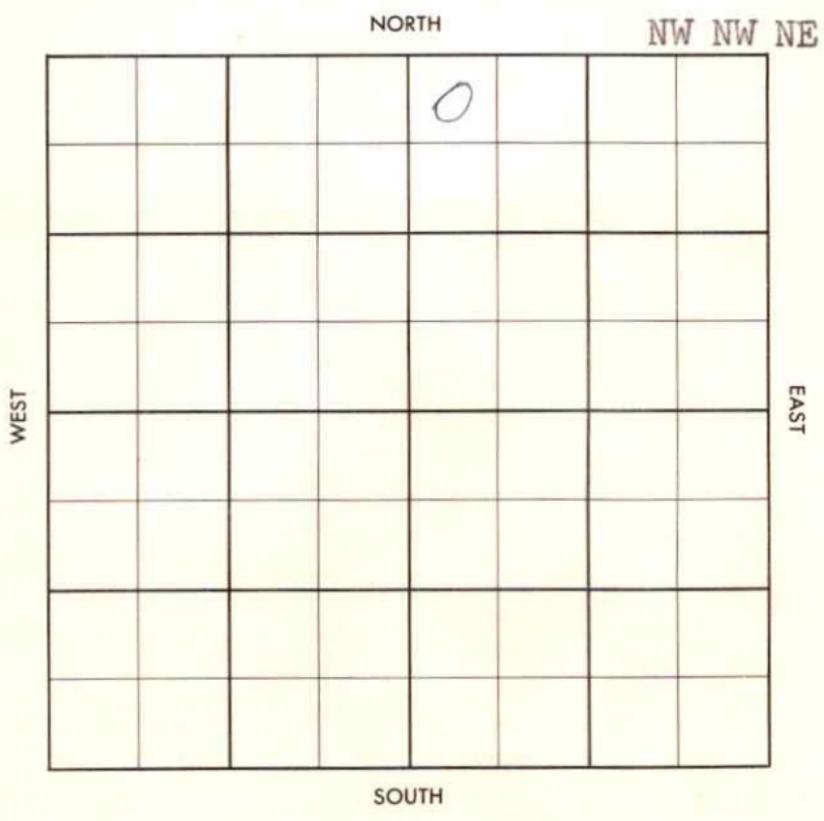

County Ellis Elev. \_\_\_\_\_  
 Sec. 28 Twp. 14 Rge. 19W  
 Company Walters Drlg.  
 FarmName Reitz "B" No. 1

Co.

TOPS	DEPTH	LOG	DATUM
Anh.			
Tp.			
H.			
Tr.			
Dg.			
Bl.			
L.			
K.C.			
B.K.C.			
Ce.			
C.			
M.			
M.			
K.			
Mz.			
Mq.			
V.			
S.			
S.			
A.			
R.			
PE.			
G.			
T.D.			

Loc. in Sec. NW NW NE

Geol. \_\_\_\_\_  
 Concr. \_\_\_\_\_

Pool TRALLS

0  
 FIRST REPORT  
 MAY 19 57

Lse

No.

Sec.

T.

R.

Date Comm. 5-11-57 Phillips - (FO)  
8" @ 235/100, Drlg. 1100

County Ellis Elev. 2197  
 Sec. 28 Twp. 14 Rge. 19W  
 Company Walters Drlg.  
 Farm Name Feitz "B" No. 1

TOPS	DEPTH	LOG	DATUM
Anh.			
TP.			
H.	3445	3446	
Tr.	3464	3467	
Dg.			
BL.			
L.	3490	3490	
K.C.	<u>Drum</u>	3622	
B.K.C.		3754	
Ce.			
Gr.	<u>sd</u>	3783	3784
M.			
M.			
K.			
Mz.			
Mo.			
V.			
S.			
S.			
A.	3788	3790	
R.			
PE.			
G.			
T.D.	3801		

Loc. in Sec. NW NW NE

Geol. \_\_\_\_\_

Contr. \_\_\_\_\_

Pool Krause

		o
	AUG 4 '57	
COMPLETE		

Date Comm. 5-11-57 Phillips - (EO)  
 8" @ 235/100, Drlg. 1100 MAY 22 '57 11) 3665

MAY 29 '57 DST 3782-91 (Acid Tool)  
 Hallid.

1 hr. sec. 90' Mdg Acid wt  
 All pres 0 5 1/2 3792/100

WOST JUN 5 '57 MICT CO 3801  
 FU 1095' oil in 14 hrs

now \$ 2.13 Bopd now 7  
 hrs TCR JUN 12 '57 JUN 19 '57

X JUL 3 '57 P. 25 Bopd + 1/2 BSW 1/2  
 P. 81 Bopd + 12% s.w. JUL 10 '57 JUL 17 '57

Co.

Loc.

No.

Sec.

T.

R.

JUL 24 '57 JUL 31 '57 AUG 8 '57 LOG 1457 Ph P.

61 Bopd + 22% wt.

28-14-19W

no more