


Section 13 Township 17 Range 1W

Well No. #1 Morrison

Company Anschutz

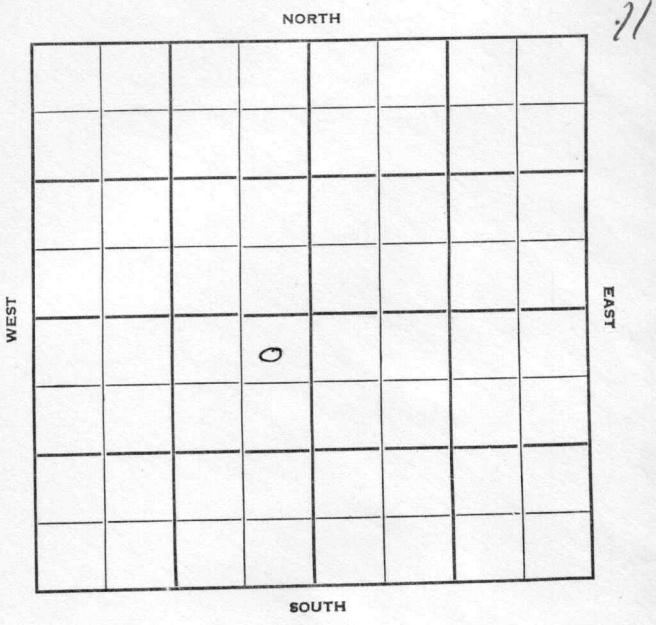

McPherson

KANSAS ✓

Sec. 13 Twp. 17 R. 1W

Well No. #1 Morrison Farm

Anschutz Company

Honaker Contractor

Wildcat

330 Ft. from N. Line


Ft. from S. Line

330 Ft. from E. Line

Ft. from W. Line

NE NE SW

Phillips DHM

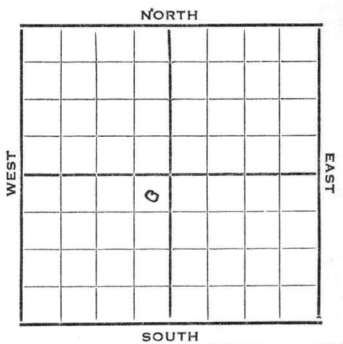

1952

Elev. 1532' REPORT

5/28

Moving In

6/11

Spud 5-29-52  
 D&A TD 2900  
 8" @ 204  
 Heeb. 2024 Doug 2084  
 Br Lime 2187 Lans. 2242  
 Miss 2858-2900 TD  
 D&A

**ABANDONED**

County **McPherson** State **Kansas**

Sec. **13** (Blk. Twp.) **17** (Sur. Rge.) **1W** Map No.

Operator **Anschutz**

Well No. **1** Farm **Morrison**

Elev. Location **NE NE SW**


**FIRST REPORT**

**330** Ft. From **N** Line **SW**

**330** Ft. From **E** Line Quarter

1st. Report **MAY 28 1952**

Completion

Remarks **Phillips - DHM**

**Honaker - Contr.**

Spudding Date

Drlg. Data **Wildcat**

**MI**

**J. G. McGEHEE**

