

KANSAS


FORM 51 5M 10-41 PETROL

McPherson

Section 16 Township 17 Range 1-W

Well No. #1 Anderson

Company Phil-Han & Adair & Morton

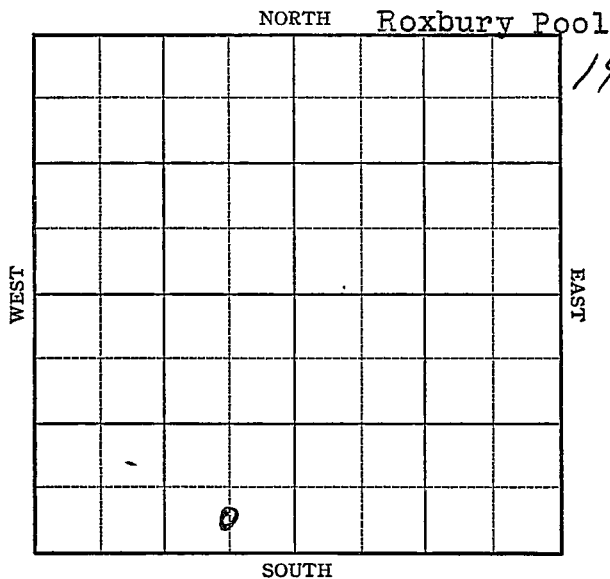

KANSAS

McPherson

Sec. 16 Twp. 17 R. 1-W

Well No. #1 Anderson Farm

Phil-Han & Adair & Morton Company

(Roxbury)


Ft. from N. Line

330 Ft. from S. Line

660 Ft. from E. Line

Ft. from W. Line

Nov. 1816

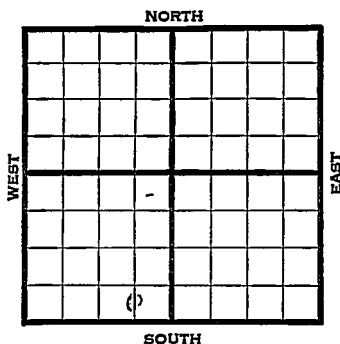[illegible]

McPherson **KANSAS**Map No. 42 Sec. 16 Twp. 17 R. 1WWell No. 1 AndersonPhil-Han & Adair & Company**FIRST REPORT**Morton

Contractor

C SL SE SW

 Ft. from N. Line330 Ft. from S. Line660 Ft. from E. Line Ft. from W. Line**SECTION PLAT**

ROXBURY POOL

Location XXXRig up

Drilling and Remarks:

RECORDCased in., ft.Sand Gas Oil Total Depth **PRODUCTION**1st 24 hrs. Nat. 1st 24 hrs. after shot Gas Cu. Ft.Dry Hole Abandoned

Date

MAR 1 8 1942 . 19 S. I. LEWIS Scout

Map No. 42 Sec. 16 Twp. 17 R. 1WWell No. 1 AndersonPhil-Han & Adair & Company**COMPLETED**Morton Contractor

C SL SE SW

SECTION PLAT

 Ft. from N. Line330 Ft. from S. Line660 Ft. from E. Line Ft. from W. Line

ROXBURY POOL

Location Rig up

Drilling and Remarks:

Miss 2635
7" @ 2635
Pump 7470 ft.

35-0

RECORD

Cased in., ft.Sand Gas Oil Total Depth 2645

PRODUCTION

1st 24 hrs. Nat. 1st 24 hrs. after shot Gas Cu. Ft.Dry Hole Abandoned

Date

MAY 6 1942 19

S. J. LEWIS Scout