

KANSAS

McPherson

Section 12 Township 17 Range 1WWell No. #1 TectorCompany Barbara Oil

Wildcat

020

NORTH

WEST

EAST

SOUTH

The figure shows a 10x10 grid map. The top edge is labeled 'NORTH' and the bottom edge is labeled 'SOUTH'. The left edge is labeled 'WEST' and the right edge is labeled 'EAST'. A small circle with the number '0' is located in the second column from the left and the fourth row from the top. The grid is composed of 10 columns and 10 rows of squares.

0									

5

McPherson

KANSAS

Sec. 12 Twp. 17 R. 1W

Well No. #1 Tector Farm

Barbara Oil Company

Wildcat


Ft. from N. Line

330' Ft. from S. Line

Ft. from E. Line

330' Ft. from W. Line

SW NW

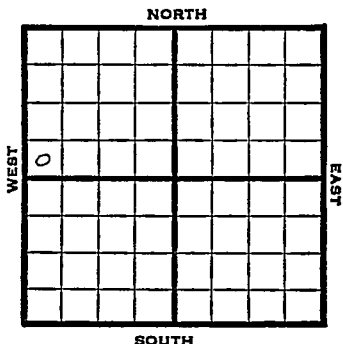

1948

Elev. 1478' REPORT

2/25

RUR

3/3

"

3/10

"

3/17

"

3/24

"

3/31

8" @ 213'

Drlg. 760'

4/7

Lans. 2208'

Miss. 2829'

TD 2876'

ABANDONED

Map No. _____ Sec. 12 Twp. 17 R. 1W

Well No. 1 Tector


Barbara Oil Company

FIRST REPORT

Contractor _____

SW NW

SECTION PLAT

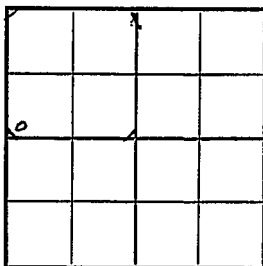

_____ Ft. from N. Line

330 Ft. from S. Line

_____ Ft. from E. Line

330 Ft. from W. Line

McPherson County

Location _____

Rig up _____

Drilling and Remarks:

R U R

RECORD

Cased _____ in., _____ ft.

Sand _____

Gas _____

Oil _____

Total Depth _____

PRODUCTION

1st 24 hrs. Nat. _____

1st 24 hrs. after shot _____

Gas _____ Cu. Ft.

Dry Hole _____

Abandoned _____

Date

FEB 25 1948 19 _____ S. J. LEWIS Scout

Map No. 42 Sec. 12 Twp. 17 R. 1W

Well No. 1 Tector

Barbara Oil

Company

ABANDONED

Contractor

SW NW

E. 1478

SECTION PLAT

o			

 Ft. from N. Line

330 Ft. from S. Line

 Ft. from E. Line

330 Ft. from W. Line

McPherson County

Location

Rig up

Drilling and Remarks:

Lease 2208

Miss 2829

RECORD

Cased in., ft.

Sand

Gas

Oil

Total Depth 2876

PRODUCTION

1st 24 hrs. Nat.

1st 24 hrs. after shot

Gas Cu. Ft.

Dry Hole

Abandoned

Date

APR 7 1948

19

S. J. LEWIS

Scout