

Ellis

KANSAS

28

14


19W

SECTION _____ TOWNSHIP _____ RANGE _____

WELL NO. #1 Feitz

COMPANY Walters Drlg.

NORTH

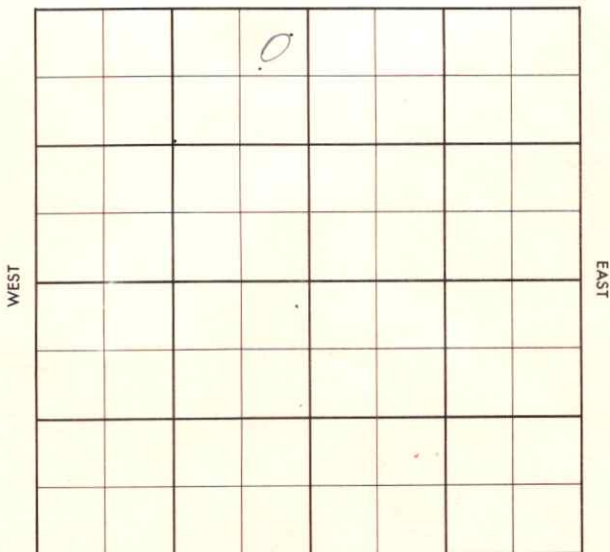

SOUTH

WILDCAT

FORM 513 SUNRAY

County Ellis Elev. _____
Sec. 28 Twp. 14 Rge. 19W
Company Walters Drlg.
Farm Name Feitz No. 1

TOPS	DEPTH	LOG	DATUM	Loc. in Sec.
Anh.				NE NE NW
Tp.				
H.				
Tr.				
Dg.				
Bl.				
L.				Geol. _____
K.C.				Cont. _____
B.K.C.				Co. tools
Ce.				Pool <u>TRAUS</u>
C.				Wildcat
M.				
M.				
K.				
Mz.				
Mq.				
V.				
S.				
S.				
A.				
R.				
Pe.				
G.				
T.D.				

SDX - 5/8 mile
FIRST REPORT
JAN 3 '57

Date Comm. 1-1-57 Phillips - DHM
8" @ 232/150 WOC

~~14~~

County Ellis Elev. 2211
 Sec. 28 Twp. 14 Rgs. 19W
 Company Walters Drly.
 Farm Name Feitz No. 1

LOG	DEPTH	LOG	DATUM	Loc. in Sec.
	2843			NE NW
	3120			
	3435			
	3477			
Dg.				
Bl.				
L.	3498			
Drum	3635			Geol.
B.K.C.	3776			Contr.
Ce. Marm	3785			Co. tools
C. sd	3793			Post house
M.				Wildcat
M.				
K.				
Mz.				
Me.				
V.				
S.				
S.				
A.	3813			COMPLETE
R.				
Pe.				
G.				
T.D.	3820			5/8 1 1/4 FEB 27 '57

Date Comm. 1-1-57 Phillips - DHM
 8" @ 232/150 WOC 3148
 DST 3792-3800 1hr 7' Md
 BHP 0/20" DST 3792-3820 1hr
 run 32' oil spkd Md BHP 0/20"
 5 1/2 3818 CO 3820 #
 5 6 M 0 2 hrs 1/2 8 85 BO no/w
 13 hrs 8 7 Boph no/w T&R
 JAN 30 '57 P. 107 BO no/w 18 hrs
 8 8 P. 150.83 BO in 24 hrs
 9 new 32' P. 168.77 BO

no wt 24 hrs
Ph P. 112 Bopd + 10 20 w
graw 32°

FEB 20 1957 FEB 21 1957