


SECTION #2 13 TOWNSHIP 17S RANGE 1W


WELL NO. #1 Becker - 10

COMPANY Richard David, etal

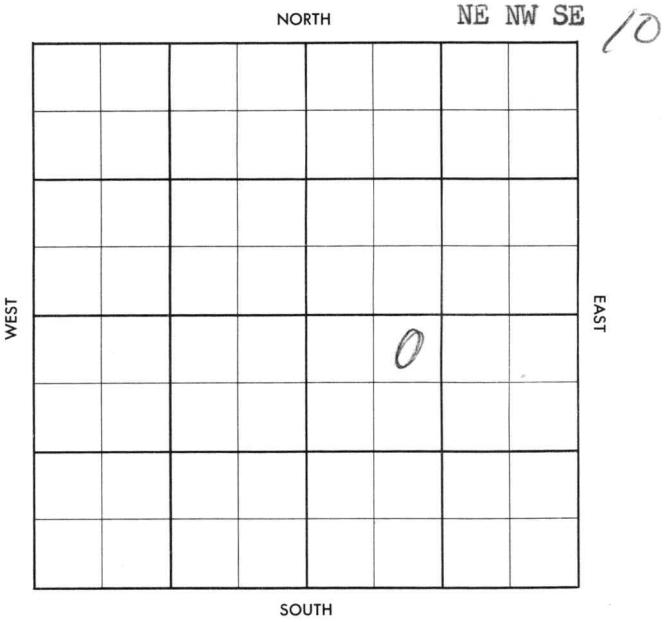



County McPherson Elev. 1536 DF  
 Sec. 13 Twp. 17 Rge. 1W  
 Company Richard Davis, etal  
 Farm Name Becker - 10 No. 1

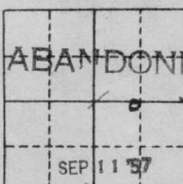TOPS	DEPTH	LOG	DATUM	Loc. in Sec.
Anh.				NE NW SE
Tp.				
H.				
Tr.				
Dg.	<u>2070</u>			
Bl.				
L.	<u>2228</u>			Geol.
K.C.				Contr.
B.K.C.				
C.				<u>Melland Tool</u>
M.	<u>2857</u>	<u>2879</u>		Pool
M.				<u>Wildcat</u>
K.				<div style="border: 1px dashed black; padding: 5px; text-align: center;">                 ABANDONED   </div>
Mz.				
Mo.				
V.				
S.				
S.				
A.				
R.				
Pe.				
G.				
T.D.	<u>2880</u>			

Date Comm. 8-27-57  
8" @ 174, DST 2870-80 SEP 11 57 DST  
2870-70 1hr rec 20' Md BH 580  
No log

DFA

Co.  
58  
No.  
Sec.  
T.  
R.