


KANSAS

FORM 51 5M BRIX

Section 6 Township 13 Range 20W

Well No. #4 Bittel "B"

Company Sunray

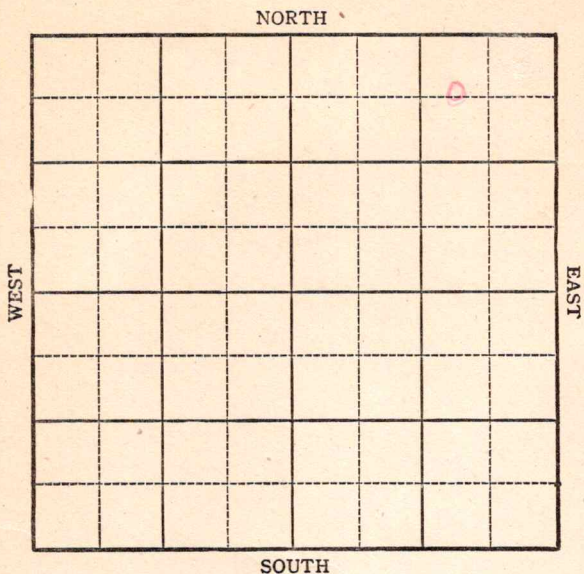

Sec. 6 Twp. 13 R. 20W


Well No. #4 Bittel "B" Farm _____

Sunray

Company _____

Ellis

NORTH

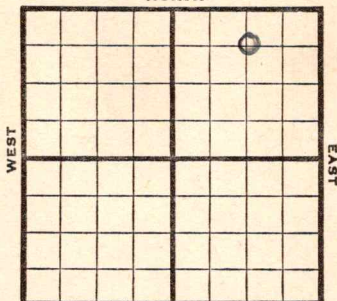

660 Ft. from N. Line

_____ Ft. from S. Line

990 Ft. from E. Line

_____ Ft. from W. Line

C W L NE NE

Edw. 2173

SOUTH

1945

R E P O R T

- 1/24 Location
- 1/31 "
- 2/7 Derrick
- 2/14 Anhy 1507
8" @ 1508
Drlg 1977
- 2/21 Drlg 2895
- 2/28 Heebner 3414
Lans 3441
BKC 3709
Cong 3809
Arb 3832
Coring 3835
- 3/7 Granite 4053
TD 4057
5" @ 4029 RUST
- 3/14 Granite 4053
5" @ 4029
TD 4057

ABANDONED

Pool Name Ellis

Map No. 70 Sec. 6 Twp. 13 R. 20W

Well No. 4 Bittel "B"

Sunray Company

FIRST REPORT

Contractor

C W L NE NE

SECTION PLAT

660 Ft. from N. Line

_____ Ft. from S. Line

990 Ft. from E. Line

_____ Ft. from W. Line

			o

Ellis

Location X

Rig up _____

Drilling and Remarks:

*Not filed
1/4 mi NW
Mc PC*

RECORD

Cased _____ in., _____ ft.

Sand _____

Gas _____

Oil _____

Total Depth _____

PRODUCTION

1st 24 hrs. Nat. _____

1st 24 hrs. after shot _____

Gas _____ Cu. Ft.

Dry Hole _____

Abandoned _____

Date

JAN 24 1945 19

S. J. LEWIS Scout

Pool Name Ellis

Map No. 70 Sec. 6 Twp. 13 R. 20 W

Well No. 4 Bittel "B"

Sunray Company

ABANDONED

Contractor

C W L N E N E

SECTION PLAT

660 Ft. from N. Line

_____ Ft. from S. Line

990 Ft. from E. Line

_____ Ft. from W. Line

Ellis

Location _____

Rig up _____

Drilling and Remarks:

Gravite 4059

5" @ 4029

RECORD

Cased _____ in., _____ ft.

Sand _____

Gas _____

Oil _____

Total Depth 4059

PRODUCTION

1st 24 hrs. Nat. _____

1st 24 hrs. after shot _____

Gas _____ Cu. Ft.

Dry Hole _____

Abandoned _____

Date

MAR 14 1945

19

S. J. LEWIS

Scout