

KANSAS McPherson County

FORM 51 5M PETROL

Section 16 Township 17 Range 1W

Well No. 6 Anderson

Company Co-op

NORTH

11

		0					

SOUTH

WEST

EAST

KANSAS

McPherson

Sec. 16 Twp. 17 R. 1W

Well No. 6 Anderson Farm

Co-op Company

Crowther


330 Ft. from N. Line

 Ft. from S. Line

990 Ft. from E. Line

 Ft. from W. Line

NW NE SW Elev. 1309

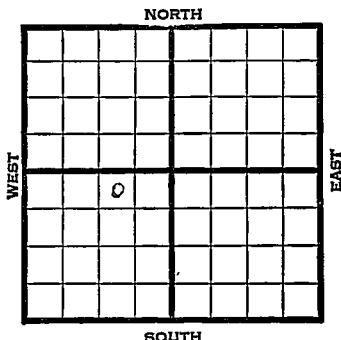

1945	REPORT
5/29	RUR
6/8	8" @ 158 Drlg. 2068
6/14	Miss 2630-41 TD
6/21	5" @ 2130 RUST
6/28	TD 2640
	1800' fluid 2 hrs 50% W
	" " " "
7/3	TD 2640 1800' fluid 2 hrs. 50% wtr.
7/11	" " " " " "
7/19	" " " " " "
7/26	" " " " " "
8/1	Miss. 2630
	5" @ 2630'
	Pump 8 oil plus 95% water. Pot
	T.D. 2640'
	Gravity 36
	COMPLETED

Kansas Pool Name CrowtherMap No. 42 Sec. 16 Twp. 17 R. 1WWell No. 6 AndersonCo-op

Company

FIRST REPORT

Contractor

NW NE SW

SECTION PLAT

	0		

330 Ft. from N. Line Ft. from S. Line990 Ft. from E. Line Ft. from W. LineMcPherson CountyLocation Rig up Drilling and Remarks:
RUR

RECORD

Cased in., ft.Sand Gas Oil Total Depth

PRODUCTION

1st 24 hrs. Nat. 1st 24 hrs. after shot Gas Cu. Ft.Dry Hole Abandoned

Date

MAY 29 1945

19

S. J. LEWIS

Scout

KANSAS

Pool Name CrowtherMap No. 42 Sec. 16 Twp. 17 R. 1WWell No. 6 Anderson

Co-op

Company

COMPLETED

Contractor

NW NE SW

E 1,1309
SECTION PLAT.330 Ft. from N. Line Ft. from S. Line990 Ft. from E. Line Ft. from W. Line

	Δ		

McPherson County

Location

Rig up

Drilling and Remarks:

*Miss 2630**5" @ 2630**Pump Soil + 95% Water**36°/hr*

RECORD

Cased in., ft.Sand Gas Oil Total Depth 2640

PRODUCTION

1st 24 hrs. Nat. 1st 24 hrs. after shot Gas Cu. Ft.Dry Hole Abandoned

Date

AUG 1 1945 19

S. J. LEWIS

Scout