

Section 16 Township 17 Range 1WWell No. #1 SpilmanCompany N.C.R.A.

	0						

NORTH

WEST

EAST

SOUTH

5

McPherson KANSAS

SEC.	TWP.	R.
16	17	1W ✓
WELL NO.		
1 Spilman		
COMPANY		FARM
N C R A		1
CONTRACTOR		

Musgrove


Henne Pool

_____ Ft. from N. Line

990 _____ Ft. from S. Line

_____ Ft. from E. Line

990 _____ Ft. from W. Line

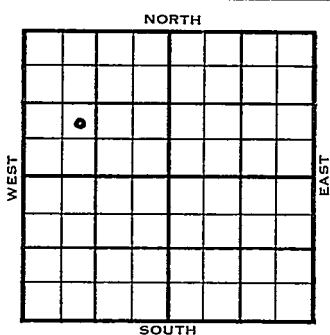

NE SW NW

1954	ELEVATION	REPORT
	1302'	

3/17 Spud 3-11-54
8" @ 162'

3/24 , NR

4/7 "

5/5 NR


5/12 "

5/19 Spud 3-11-54 D & A TD 2628
8" @ 162 Heeb 2898 Miss 2618
TD 2621 5" @ 2619 DD 2622
250 A DD 2623 S/3-1/3 BF 3 hr.
50% wtr. S/3 1/2 BO 6 1/2 BW 10 hr.
500 A S/1 1/4 BO 7 BW PB 2622
CO to 2623 SSO & wtr. S/3 1/2 BO
6 1/2 BW 10 hr. 500 A S/1 1/4 BO 7 BW
PB 2622 fra. DD 2628 D & A

ABANDONED

5

J. G. McGEHEE

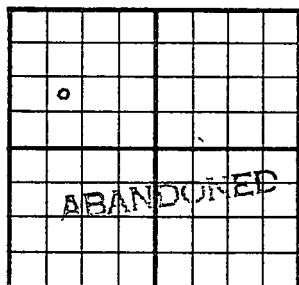County McPherson State KansasSec. 16 (Blk.
Twp.) 17 (Sur.
Rge.) 1W Map No.Operator N C R AWell No. 1 Farm SpilmanElev. 1302 Location NE SW NW990Ft. From S Line NW990Ft. From W Line Quarter1st. ReportCompletion MAY 19 1954Remarks Henne PoolMusgrove - Contr.Spudding Date 3-11-54Drilg. Data D & A TD 26288" @ 162 Heeb. 2898 Miss. 2618TD 2621 5" @ 2619 DD 2622 250 ADD 2623 S/ 3 1/3 bf 3 hr. 50% wtr.S/ 3 1/2 bo 6 1/2 bw 10 hr. 500 AS/ 1 1/4 bo 7 bw PB 2622 CO to 2623SSO & wtr. S/ 3 1/2 bo 6 1/2 bw 10 hr.500 A S/ 1 1/4 bo 7 bw PB 2622 fracDD 2628D & A