


Section 16 Township 13 Range 20W

Well No. #2 Adair Estate

Company Victor Drlg.

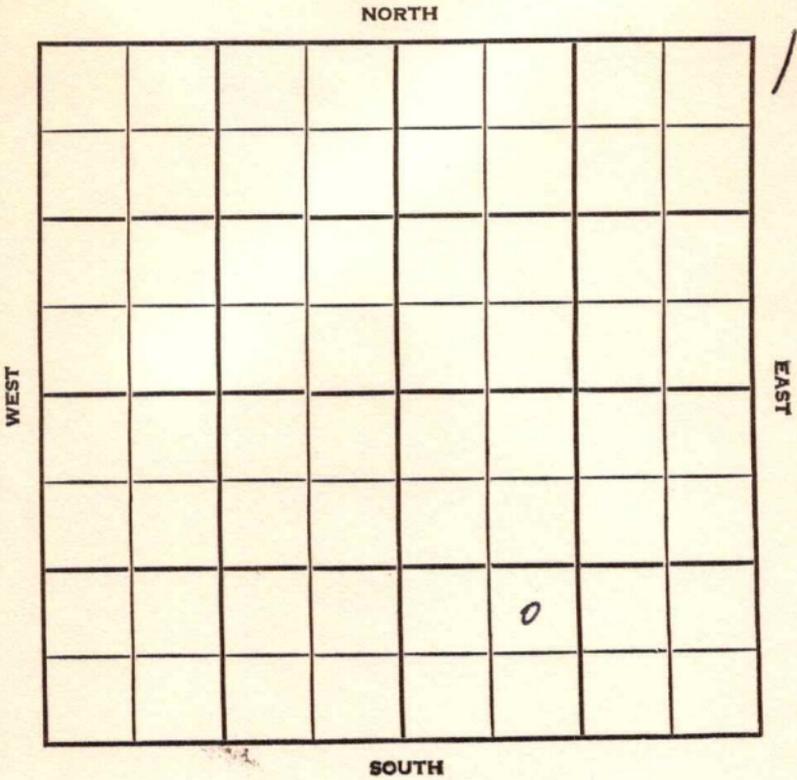

Ellis

KANSAS

SEC.	TWP.	R.
16	13	20W


WELL NO. #2 Adair Estate. FARM

COMPANY Victor Drlg.

CONTRACTOR Co. Tools.

E. Raynesford Pool

_____ Ft. from N. Line
 990 _____ Ft. from S. Line
 _____ Ft. from E. Line
 990 _____ Ft. from W. Line

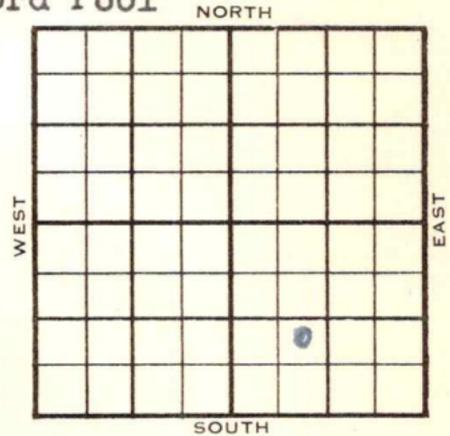

NE SW SE

1955	ELEVATION 2195	REPORT
------	-------------------	--------

2/23 Spud 2-20-55
 8" @ 188'
 Drlg. 671'

6/1 DST 3872-84, open 1 hr. Rec. 30' mud O#
 TD 3933 5" @ 3876 CO to 3933 Comp SWD w
 well

Tops:	Depth	Datum
H.	3454	1259
Tr.	3473	1278
KC	3491	1296
BKC	3793	1548
A	3872	3874 1677
TD:	3933	

ABANDONED

County Ellis Elev. 2195
 Sec. 16 Twp. 13 Rge. 20W
 Company Victor Drlg.
 Farm Name Adair Est. No. 2

TOPS	DEPTH	LOG	DATUM	Loc. in Sec.
Anh.				NE SW SE
Tr.				
H.	<u>3454</u>		<u>1259</u>	
Tr.	<u>3473</u>		<u>1278</u>	
Dg.				
Bl.				
L.				
K.C.	<u>3491</u>		<u>1296</u>	Geol.
B.K.C.	<u>3793</u>		<u>1548</u>	Contr.
Ce.				
C.				
M.				
M.				Pool
K.				
Mz.				E. Raynesford
Me.				
V.				
S.				
S.				
A	<u>3872</u>	<u>3874</u>	<u>1677</u>	
R.				
Pe.				
G.				
T.D.	<u>3933</u>			



Date Comm. 2-20-55 JUN 1 1955
8" @ 188/100 DST 3872-84 open 1 hr.
Rec. 30' mud O# TD 3933 5" @ 3876
CO to 3933 Comp. SWD well

Ellis