

Ellis

KANSAS

SECTION 16 TOWNSHIP 13 RANGE 20 W

WELL NO. #5 Brungart

COMPANY Victor Drlg.

NORTH

WEST

EAST

	0						

12

SOUTH

Ellis

KANSAS

SEC.	TWP.	R.
16	13	20 W

WELL NO. # 5 Brungart FARM

COMPANY Victor Drlg.

CONTRACTOR Garvey


E. Raynesford

_____ Ft. from N. Line

_____ Ft. from S. Line

_____ Ft. from E. Line

_____ Ft. from W. Line

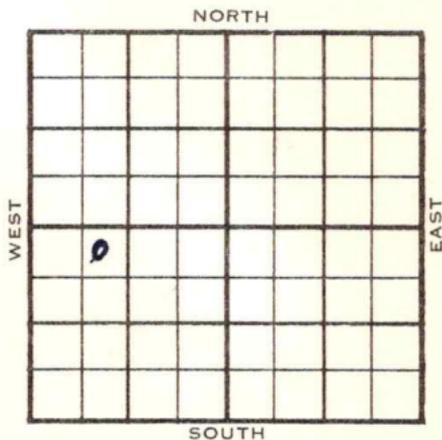

NE NW SW

SDX - 3/8 Mile

	ELEVATION	REPORT
1955	2208'	

12/21 Comm. 12-15-55
8" @ 205/150
Drlg. 2730'
Anh. 1550'

12-29 5 1/2" @ 3861/125
1956

1-6 Heeb. 3461,
Lans. 3500
BKC 3718
Marm.Chert. 3784
Cherty Cong. 3847
Arb. 3854
TD 3870,
Cored 3859-70, ~~###~~ full rec., good sat.
CO to 3870, 500 A
S/ 1 bfph, 90% wtr., 6 hrs.
Waiting on orders.

1-12 No report

1-19 No report

1-27 "
2-1 DD 3871

FU 1300' oil,
S/ 10 boph,
Comp. 44 bopd, 12% wtr.
TD 3871

County Ellis Elev. 2208
 Sec. 16 Twp. 13 Rge. 20W
 Company Victor Drlg.
 Farm Name Brungart No. 5

TOPS	DEPTH	LOG	DATUM
Anh.	1550		
Tr.			
Dg.			
B.L.			
L.			
K.C.			
B.K.C.			
Ce.			
C.			
M.			
M.			
K.			
Mz.			
Ma.			
V.			
S.			
S.			
A.			
R.			
Pe.			
G.			
T.D.			

Loc. in Sec. NE NW SW
 Geol. _____
 Contr. _____
 Pool Geovoy
EX-15
E. Raynesford
50X - 3/8 mile
 FIRST REPORT
 DEC 21 1955

Date Comm. 12-15-55
8" @ 205/150 drlg. 2730

[Large red scribble]

Co.
Lse.
No.
Sec.
T.
R.

County Ellis Elev. 2208
 Sec. 16 Twp. 13 Rge. 20W
 Company Victor Drlg.
 Farm Name Brungart No. 5

TOPS	DEPTH	LOG	DATUM	Loc. in Sec.
Anh.	1550			NE NW SW
Tp.				
H.	3461			
Tr.				
Dg.				
Bl.				
L.	3500		1292	Geol.
K.C.				
B.K.C.	3718		1510	Contr.
Ce. <u>Mamoch</u>	3784		1576	Garvey
C. <u>Cherty Cong.</u>	3847		1639	
M.				Pool
M.				E. Raynesford
K.				
Mz.				
Me.				
V.				
S.				
S.				
A.	3854		1646	COMPLETE
R.				
Pe.				
G.				
T.D.	3870			

Date Comm. 12-15-55 FEB 1 1956
 8" @ 205/150 5 1/2" @ 3861/125
 TD 3870 CO to 3870 500 A
 S/ 1 bfph 90% wtr. 6 hr. DD 3871
 FU 1300' oil S/ 10 boph
 Comp. 44 bopd 12% wtr.

Co.
Lse.
No.
Sec.
T.
R.