


Cowley

Form 51-5M-11-31-Palace

Map No. KANSAS Sec. 8 Twp. 34 R. 3

Well No. 1 Mycoff Farm  
M B Archibal Company

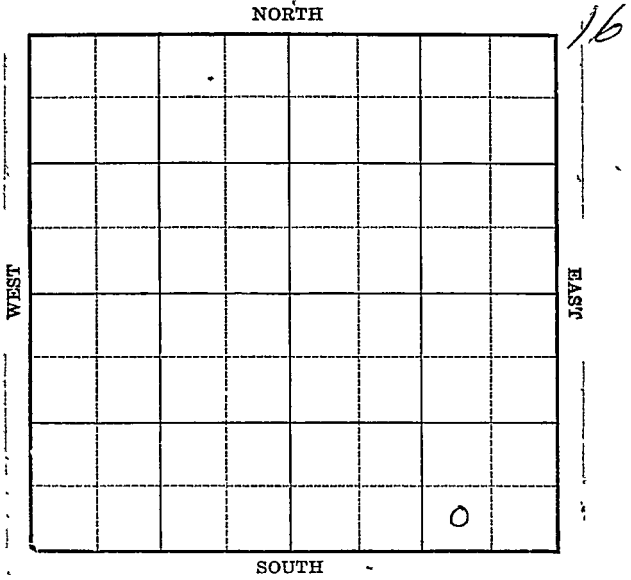

Location \_\_\_\_\_

Drilling Remarks \_\_\_\_\_

\_\_\_\_\_

\_\_\_\_\_

**RECORD**

Cased \_\_\_\_\_ in. \_\_\_\_\_ ft.

Sand \_\_\_\_\_

Gas \_\_\_\_\_

Oil \_\_\_\_\_

Total Depth \_\_\_\_\_

Rig Up \_\_\_\_\_

Drilling Remarks \_\_\_\_\_

\_\_\_\_\_

\_\_\_\_\_

**PRODUCTION**

1st 24 hrs. Nat. \_\_\_\_\_

1st 24 hrs. after shot \_\_\_\_\_

Gas \_\_\_\_\_ cu. ft. \_\_\_\_\_

Dry Hole \_\_\_\_\_

Abandoned \_\_\_\_\_

*Cowley*

**KANSAS**

Map No. \_\_\_\_\_ Sec. 8 Twp 34 R. 3<sup>E</sup>

Well No. 1 Wycoff Farm \_\_\_\_\_


M.B. Armed et al Company \_\_\_\_\_

\_\_\_\_\_ Ft. from N. Line

330' Ft. from S. Line

990' Ft. from E. Line

\_\_\_\_\_ Ft. from W. Line

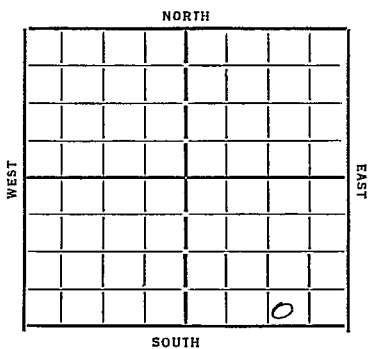

Date 1924

**REPORT**

1/10 Rig

1/17 1/24 -

1/31 dry 170

2/7 " 727

2/14 " 1527

2/23 4 M Gas 1840-75 PBP

2/28 Gas 1840-75 TD 47A Gas

**COMPLETED**

Map No. 1 Sec. 8 Twp. 34 R. 3E

Well No. 1-Wycoff

M. B. Armer et al Company

Contractor

**FIRST REPORTS**

**SECTION PLAT**

..... Ft. from N. Line

330 Ft. from S. Line

990 Ft. from E. Line

..... Ft. from W. Line

			0

Location.....

Rig up.....

Drilling and Remarks:

*Rig*

**RECORD**

Cased..... in., ..... ft.

Sand.....

Gas.....

Oil.....

Total Depth.....

**PRODUCTION**

1st 24 hrs. Nat.....

1st 24 hrs. after shot.....

Gas..... Cu. Ft.

Dry Hole.....

Abandoned.....

Date

1-10-34 192 P. Mannscheck Scout

Map No. 1 Sec. 8 Twp. 34 R. 3E

Well No. 1-Wyent

M B Amer et al Company

Contractor

**COMPLETED**

SECTION PLAT

			0

..... Ft. from N. Line

330 Ft. from S. Line

990 Ft. from E. Line

..... Ft. from W. Line

**COMPLETED**

RECORD

Location.....

Cased.....in., .....ft.

Rig up.....

Sand.....

Drilling and Remarks:

Gas.....

gas 1870-75

Oil.....

Total Depth 1875

PRODUCTION

4 mil gas

1st 24 hrs. Nat.....

1st 24 hrs. after shot.....

Gas.....Cu. Ft.

Dry Hole.....

Abandoned.....

Date

2-28-34 192 P. Manscheck Scout