

SEC.	TWP.	R.
16	13	20W


WELL NO. #4 Brungart FARM

COMPANY Victor Drlg.

CONTRACTOR Co. Tools.

E. Raynesford Pool

_____ Ft. from N. Line
 990 _____ Ft. from S. Line
 _____ Ft. from E. Line
 990 _____ Ft. from W. Line

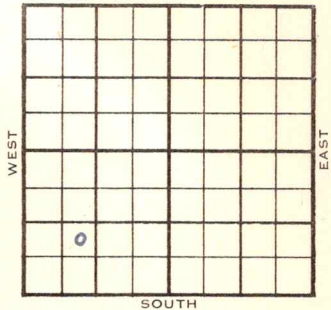

NE SW SW

	ELEVATION	REPORT
1955	2 208'	
1/19	Spud 1-17-55 Drlg. 1500'	
3/23	Spud 1-17-55, Oil Well, TD 3904 8" @ 202; Heeb 3458, Lans 3497, BKC 3762, Arb 3848, TD 3904, 5" @ 3850, CO to 3904, P/30 BOPD,, DST 3845-81, open 1 hr Rec. 1700' MO. 30' SW, 910# DST 3847-81, open 2 hr,, Rec 1800' MO, 90' SW 940# P/ 35 BOPD 10% wtr. Comp. 26 BOPD 12% wtr.	

COMPLETED

