


Section 16 Township 13 Range 20 W

Well No. #1 Weisner

Company V. R. Gallagher (Victor Drlg.)

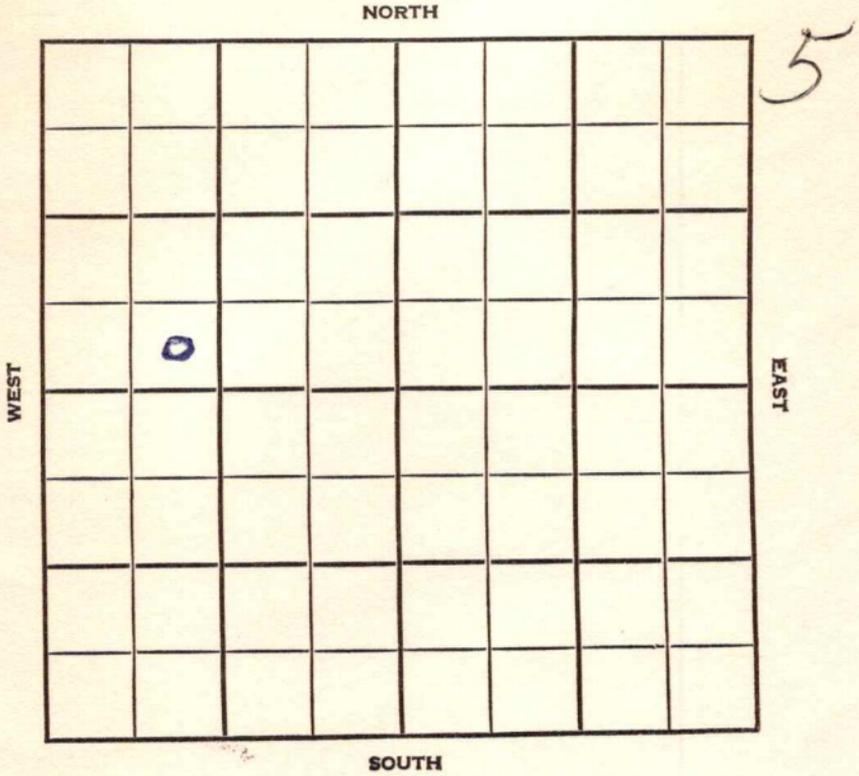

Ellis

KANSAS

SEC. 16	TWP. 13	R. 20W
------------	------------	-----------

WELL NO. #1 Weisner FARM

COMPANY V.R. Gallagher (Victor Drlg.)

CONTRACTOR L & J


Raynesford

_____ Ft. from N. Line

_____ Ft. from S. Line

_____ Ft. from E. Line

860 _____ Ft. from W. Line

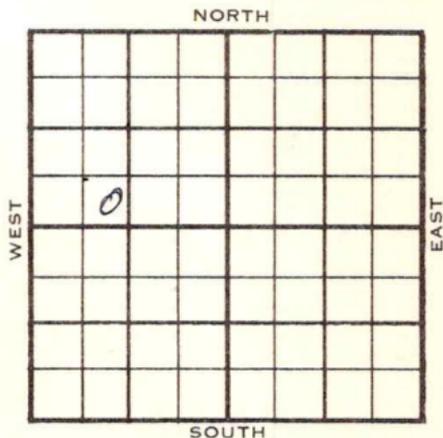

SE SW NW

$\frac{1}{4}$ mile - SDX

	ELEVATION	REPORT
1956	2208'	

- 2-22 RJR
- 3-1- Spud 2-20-56
8 5/8" @ 212/150
Fsg. @ 3309
- 3-8 No report
- 3-14 D & A
Anh. 1555
H. 3473
KC 3510
BKC 3730
- 7 Marm 3807
Cg. Chert 3861
A 3871


ABANDONED

County Ellis Elev. _____
 Sec. 16 Twp. 13 Rge. 20W
 Company V. R. Gallagher (Victor Drlg.)
 Farm Name Weisner No. 1

TOPS	DEPTH	LOG	DATUM	Loc. in Sec.																				
Anh.				SE SW NW																				
Tp.																								
H.				860' WL																				
Tr.																								
Dg.				Geol. _____																				
Bl.																								
L.				Contr. _____																				
K.C.																								
B.K.C.				L & J																				
Ce.																								
C.				Pool _____																				
M.																								
M.				Raynesford																				
K.																								
Mz.				<table border="1"> <tr> <td></td> <td></td> </tr> </table>																				
Mq.																								
V.																								
S.																								
S.																								
A																								
R.																								
PE.																								
G.																								
T.B.																								

FEB 22 '56
 FIRST REPORT
 1/4 mile

Date Comm. RUR

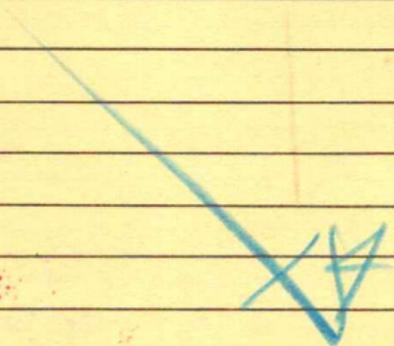

County Ellis Elev. 2208
 Sec. 16 Twp. 13 Rge. 20W
 Company V. R. Gallagher (Victor Drlg.)
 Farm Name Weisner No. 1

TOPS	DEPTH	LOG	DATUM	Loc. in Sec.
Anh.	<u>1555</u>			SE SW NW
TP.				
H.	<u>3473</u>			860' WL
Tr.				
Dg.				
Bl.				
L.				
K.C.	<u>3510</u>		<u>1302</u>	Geol.
B.K.C.	<u>3730</u>		<u>1522</u>	Contr.
Ce.				L & J
C. <u>Mazzy</u>	<u>3807</u>		<u>1599</u>	
M. <u>G. chert</u>	<u>3861</u>		<u>1653</u>	Pool
M.				
K.				Raynesford
Mz.				
Mq.				
V.				
S.				
S.				
A.	<u>3871</u>		<u>1663</u>	
R.				
PE.				
G.				
T.D.				

Date Comm. 2-20-56
8 5/8" @ 212/150

MAR 14 1956

D & A

Co.

Lse.

No.

Sec.

T.

R.