


Section 9 Township 34 Range 3E

Well No. #1 Lovell

Company McNish & Grallop

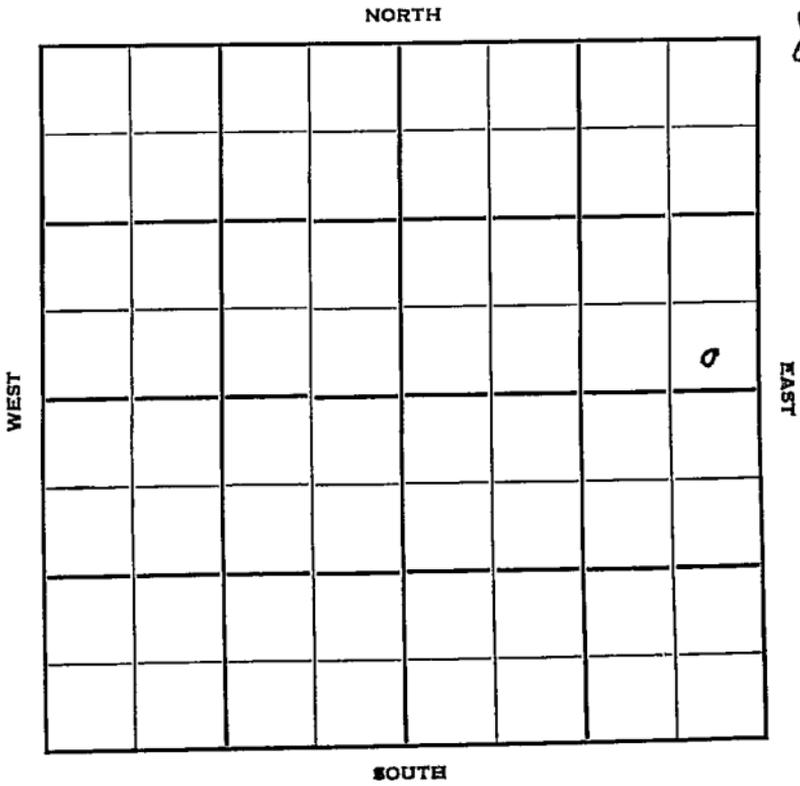

Cowley

KANSAS ✓

Sec. 9 Twp. 34 R. 3E

Well No. #1 Lovell Farm

McNish & Grallop Company

Contractor

Ft. from N. Line

400


Ft. from S. Line

330

Ft. from E. Line

Ft. from W. Line

SE SE NE

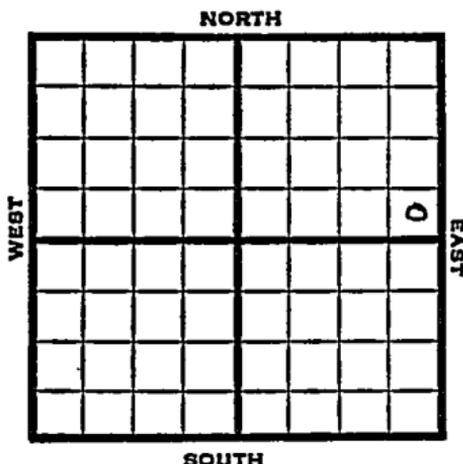

1952

Elev. 1094' REPORT

10/8

Location

12/3

Spud 10-22-52

D&A

TD 3380'

8" @ 110

Stal. 2205, Layton 2588'

DST 2588-2607, opn 1/2 hr., rec.

220' oily mud & o&gcm

KC 2773, Oswego 2977, Miss

3310

TD 3380

5" @ 2589

PB 2595 sd-frac HFW

D&A

ABANDONED

County Cowley State Kansas

Sec. 9 (Blk.) 34 (Sur.) 3E Map No.

Operator McNish & Gallop

Well No. 1 Farm Lovell

Elev. _____ Location SE SE NE

400 Ft. From S Line NE

330 Ft. From E Line Quarter

Ist. Report OCT 8 1952

Completion _____


Remarks _____

Spudding Date _____

Drlg. Data _____

Location

J. G. MCGEE

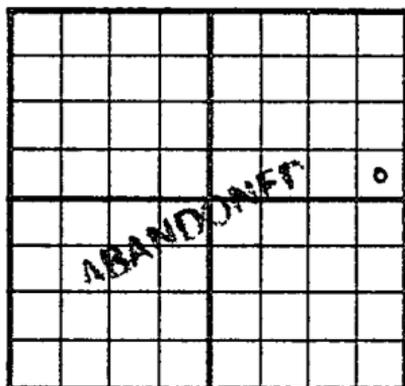County Cowley State KansasSec. 9 (Blk. (Twp.) 34 (Sur. Rge.) 3E Map No.Operator McNish & GrallopWell No. 1 Farm LovellElev. 1094 Location SE SE NE400 Ft. From S Line NE330 Ft. From E Line Quarter

1st. Report

Completion DEC 3 1952

Remarks

Spudding Date 10-22-52Drilg. Data D & A TD 33808" @ 110 Stal. 2205 Layton 2588DST 2588-2607 open $\frac{1}{2}$ hr. Rec. 220' oilymud & o & gcm KC 2773 Oswego 2977Miss. 3310 TD 3380 5" @ 2589PB 2595 sd-frac HFVD & A