

Section 9 Township 34 Range 3EWell No. #1 LovellCompany McNish & Grallop

NORTH

2

				0			

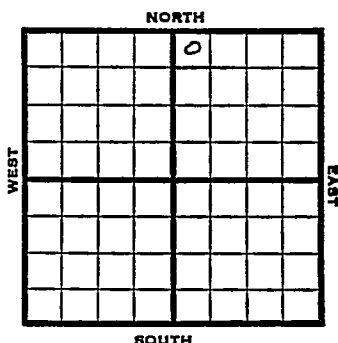
SOUTH

WEST

EAST

Cowley

KANSAS

Sec. 9 Twp. 34 R. 3EWell No. #1
#2 Lovell FarmMcNish & Grallop CompanyWatson Drlg. - Contr. Contractor330 Ft. from N. Line Ft. from S. Line Ft. from E. Line330 Ft. from W. Line

NW NW NE

1953 Elev. 1097'

REPORT

3/4 R U R

4/8 Spud 3-7-53
 Oil Well
 TD 3304
 8" @ 92
 Stal 2377, Layton 2586, KC 2776, Bart
 3286
 TD 3304
 5" @ 3300
 CO to 3304, PB 3300, 22/3292-3300,
 3 bopd sd-oil-frac
 C_{mp}. 25 bopd

COMPLETED

County **Cowley** State **Kansas**

Sec. 9 (Blk. Twp.) 34 (Sur. Rge.) 3E Map No.

Operator McNish & Grallop

Well No. 2 Farm Lovell

Elev.	Location	NW	NW	NE
-------	----------	----	----	----

0

FIRST REPORT

330 Ft. From N Line NE

330 Ft. From W Line Quarter

1st. Report MAR 4 1953

Completion

Remarks

Watson Drlg. - Contr.

Spudding Date

Drlg. Data

R U R

D-211923

Map No. _____ Sec. 9 Twp. 34 R. 3EWell No. 1 Lovell

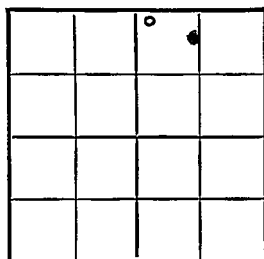
McNish & Grallop _____ Company

CORRECTION

Contractor

NW NW NE

SECTION PLAT

330 Ft. from N. Line

_____ Ft. from S. Line

_____ Ft. from E. Line

330 Ft. from W. Line

Cowley County

Location _____

Rig up _____

Drilling and Remarks:

Reported
#2 Lovell

RECORD

Cased _____ in., _____ ft.

Sand _____

Gas _____

Oil _____

Total Depth _____

PRODUCTION

1st 24 hrs. Nat. _____

1st 24 hrs. after shot _____

Gas _____ Cu. Ft.

Dry Hole _____

Abandoned _____

Date

MAR 25 1953 19

J. G. McGEHEE

Scout

County Cowley State Kansas
 Sec. 9 (Blk.) 34 (Sur.) 3E Map No.
 Operator McNish & Grallop
 Well No. 1 Farm Lovell
 Elev. 1097 Location NW NW NE

330 Ft. From N Line NE330 Ft. From W Line Quarter1st. Report Completion APR 8 1952Remarks Watson Drlg. - Contr.Spudding Date 3-8-53

Drlg. Data Oil well TD 3304
8" @ 92 Stal. 2377 Layton 2586
KC 2776 Bart. 3286 TD 3304 5" @ 3300
CO to 3304 PB 3300 22/ 3292-3300
3 bopd sd-oil-frac Comp. 25 bopd

J. G. McGEHEE