


Ellis

KANSAS

SECTION 17 TOWNSHIP 13S RANGE 20W

WELL NO. #1 P.W. Nicholson

COMPANY G.F. Atkinson

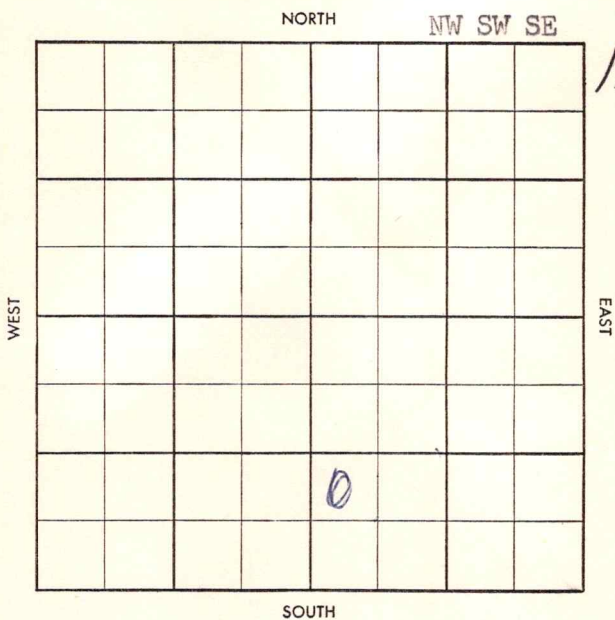

Twp ~~X~~ Pool ~~Ellis~~
 Co. ~~X~~ Facet ~~X~~

9-513-B

County Ellis Elev 22070F 2210RA
 Sec. 17 Twp. 13 Rge. 20W
 Company G. F. Atkinson
 Farm Name P. W. Nicholson No. 1

TOPS	DEPTH	LOG	DATUM
Anh.	1535		
Tp.	3237		
H.	3472		
Tr.	3491		
Dg.			
B.L.			
L.	3510		
K.C.			
B.K.C.	3758		
Ce. <u>Mann</u>	3811		
C.			
M.			
M.			
K.			
Mz.			
Mq.			
V.			
S.			
S.			
A.	3892		
R.			
Pf.			
G.			
T.D.	3920		

Loc. in Sec. _____
 NW SW SE
 Geol. _____
 Contr. _____
 Golden Cat
 Pool _____
 Raynesford
 ABANDONE
 JUN 25 '58
 0

Date Comm. 4-25-58
 Location APR 26 '58 APR 2 '58 APR 9 '58 APR 16 '58 APR 23 '58
APR 30 '58 8" 1540 921 20
MAY 7 '58 3532 MAY 14 '58 MAY 21 '58 MAY 28 '58 JUN 3 '58
JUN 11 '58 JUN 18 '58 JUN 25 '58 DST 3814-33 1hr
45' M / SK soil FP 60-400 BHP 920/30"
PST 3833-54 30" 9' M BHP 1220
FPO DST 3875-45 1hr to 55' MSW
FPO-0 BHP 1160/30"

D6A