


Russell

KANSAS

SECTION 21 TOWNSHIP 14 RANGE 13W

WELL NO. #4 Graham

COMPANY Smokey Hill Petroleum

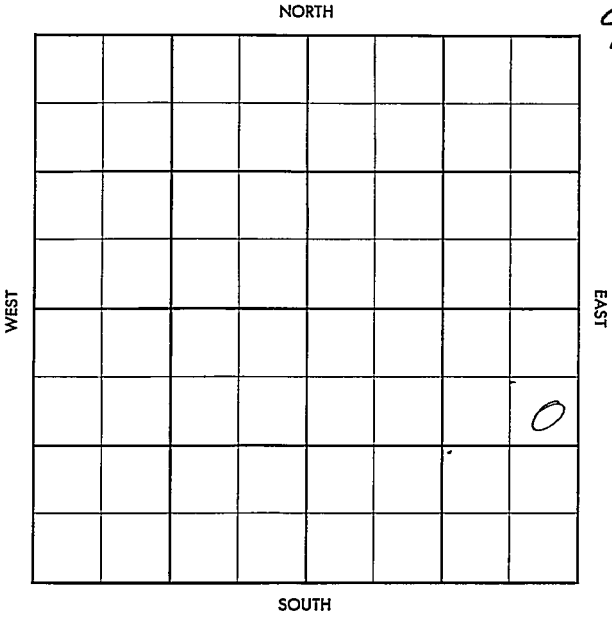

Co.

County Russell Elev. 1768
 Sec. 21 Twp. 14 Rge. 13W
 Company Smokey Hill Petroleum
 Farm Name Graham No. 4

TOPS	DEPTH	LOG	DATUM
Anh.			
Tr.			
Dg.			
Bl.			
L.			
K.C.			
B.K.C.			
Ce.			
C.			
M.			
M.			
K.			
Mz.			
Me.			
V.			
S.			
S.			
A.			
R.			
PE.			
G.			
TD.	<u>2313</u>		

Loc. in Sec. SE NE SE
 Geol. _____
 Contr. _____
 Louis Mai Ca
 le Tools
 Pool
 Hall-Gurney

1st

COMPLETE
 NOV 23 '56

No.

Date Comm. _____
 Location SE 20 '56 9-23-56
220 OCT 3 " 10" 400 858
700 960 OCT 10 '56 2140
OCT 17 '56 7" @ 2309/75 co 2313
1st 550 1/2 no inc to frac. OCT 24 '56
frac (channelled) PB 2300
45/2285-89 frac. \$ LD OCT 31 '56
50d co REP 48/2285-89 1/2
\$ LD. NOV 7 '56 Lost LD frac. \$ 16W

Sec.

T.

R.

FORM 513-1 SUNRAY

NOV 13 '56 NOV 21 '56

P. 40 Bopd

no/wt

21-14-13

se ne se

County Russell Elev. _____
 Sec. 21 Twp. 14 Rgs. 13W
 Company Smokey Hill Petroleum
 Farm Name Graham No. 4

TOPS	DEPTH	LOG	DATUM	Loc. in Sec.
Anh.				SE NE SE
Tp.				
H.				
Tr.				
Dg.				
Bl.				
L.				Geol. _____
K.C.				Contr. _____
B.K.C.				Louis Mai Ca
Ce.				le Tools
C.				Pool
M.				Ha 77 - Gurney
M.				
K.				
Mz.				
Mo.				
V.				
S.				
S.				
A.				
R.				
PE.				
G.				
T.D.				

FIRST REPORT
 SEP 19 '56

Date Comm. _____

Location SEP 26 '56

[Handwritten scribbles and signatures]

Co.
No.
Sec.
T.
R.