


Ellis

KANSAS

Section 18 Township 13 Range 20W

Well No. #1 Stebbins "A"

Company Imperial Pet.

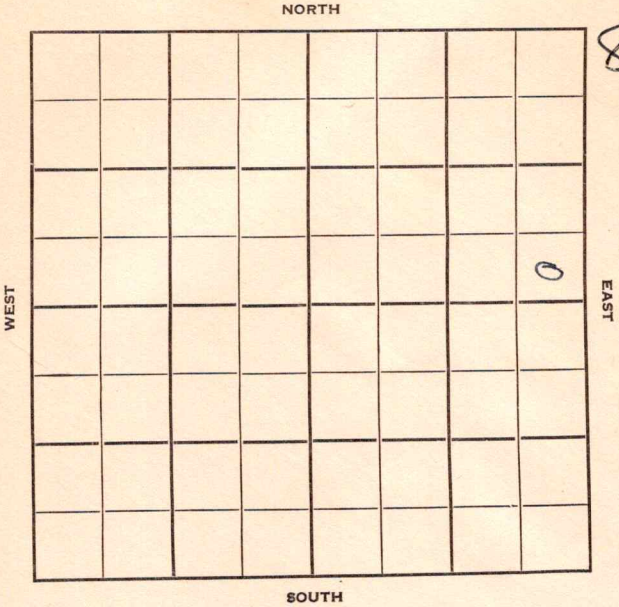

Ellis

KANSAS

Sec. 18 Twp. 13 R. 20W ✓

Well No. #1 Stebbins "A" Farm

Imperial Petr. Company

Imperial Contractor


Ft. from N. Line

330 Ft. from S. Line

330 Ft. from E. Line

Ft. from W. Line

SE SE NE

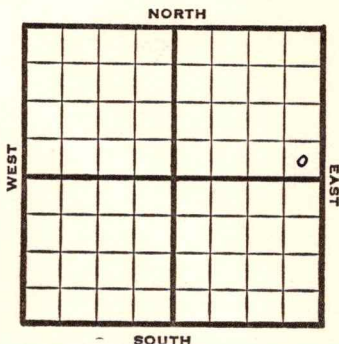

1952 Elev. 2196' REPORT

10/1 Spud 9-28-52
8" @ 197

10/15 Spud 9-28-52
D&A TD 3900'
8" @ 197' Heeb. 3454 Lans. 3491
DST 3516-32 open 1 hr. rec. 25' mud
10' ocm 1250#

Cong. 3804

DST 3800-08 open 45 min. rec. 15' ocm
DST 3855-80 ppen 38 min. rec. 10' mud
DST 3848-90 open 1 hr. rec. 160' wtr.
& mud TD 3900 D&A

ABANDONED

County **Ellis** State **Kansas**
 Sec. **18** (Blk.) **13** (Sur.) **20W** Map No.
 (Twp.) (Rge.)
 Operator **Imperial Pet.**
 Well No. **1** Farm **Stebbins "A"**
 Elev. Location **SE SE NE**

FIRST REPORT

330 Ft. From **S** Line **NE**
330 Ft. From **E** Line Quarter
 1st. Report **OCT 1 1952**
 Completion
 Remarks
Imperial - Contr.
 Spudding Date **9-28-52**

Drlg. Data

8" @ 197

J. G. McGEHEE

County Ellis State KansasSec. 18 (Blk.) 13 (Sur.) 20W Map No.Operator Imperial Pet.Well No. 1 Farm Stebbins "A"Elev. 2196 Location SE SE NE330 Ft. From S Line NE330 Ft. From E Line Quarter

1st. Report

Completion OCT 15 1952Remarks Rainfort PoolImperial - Contr.Spudding Date 9-28-52Drilg. Data D & A TD 39008" @ 197 Heeb. 3454 Lans. 3491DST 3516-32 open 1 hr. Rec. 25' mud10' ocm 1250# Cong. 3804 DST 3800-08open 45 min. Rec. 15' ocm DST 3855-80open 38 min. Rec. 10' mud DST 3848-90open 1 hr. Rec. 160' water & mudTD 3900D & A

J. G. McGEHEE