

KANSAS

Form 51-5M-7-39-Palace

Russell

Section 21 Township 14 Range 13-W

Well No. #2 Graham

Company Coralena


° Hall Pool

NORTH

WEST

EAST

SOUTH

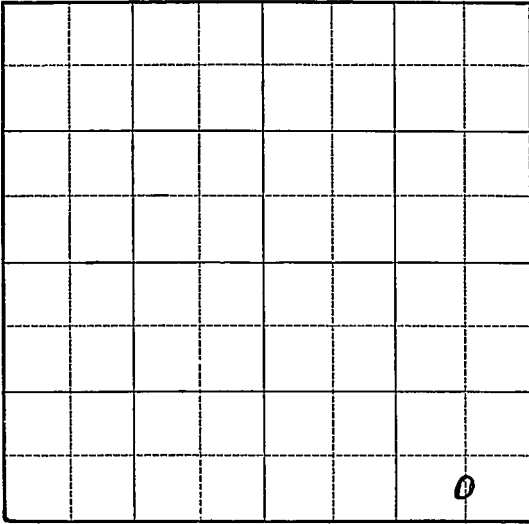

16

0

Sec. 21 Twp. 14 R. 13-W

Well No. #2 Graham Farm

Coralena Company

(Hall)


_____ Ft. from N. Line

330 Ft. from S. Line

660 Ft. from E. Line

_____ Ft. from W. Line

Elev. 1758

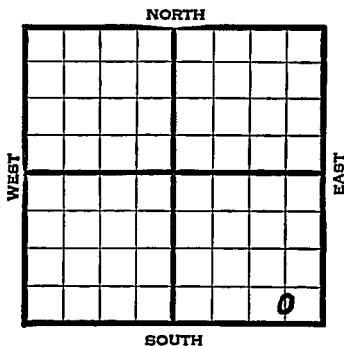

1940	REPORT
5/8	Derrick.
5/16	10" - 200' Anhy 697'
	Drlg. 1100'
5/23	Topeka 2640' Lans. 2911-13' TD
	Run pipe.
5/29	5 1/2" - 2912' RUST.
6/5	Lans. 2911'
	5" - 2912'
	T.D. 2968'
	No shows.
	ABANDONED

Map No. 72 Sec. 21 Twp. 14 R. 13WWell No. 2 Graham
Coralena Company

Contractor

FIRST REPORT

C S L SE SE

_____ Ft. from N. Line

330 Ft. from S. Line660 Ft. from E. Line

_____ Ft. from W. Line

SECTION PLAT

			o

HALL POOL

Location _____

Rig up _____

Drilling and Remarks:

Derrick

RECORD

Cased _____ in., _____ ft.

Sand _____

Gas _____

Oil _____

Total Depth _____

PRODUCTION

1st 24 hrs. Nat. _____

1st 24 hrs. after shot _____

Gas _____ Cu. Ft.

Dry Hole _____

Abandoned _____

Date

MAY 8 1940 19

S. J. LEWIS

Scout

Map No. 72 Sec. 21 Twp. 14 R. 13WWell No. 2 GrahamCoralena

Company

Contractor

ABANDONED**SECTION PLAT**

C S L SE SE

_____ Ft. from N. Line

330 Ft. from S. Line660 Ft. from E. Line

_____ Ft. from W. Line

HALL POOL

			o

Location _____

Rig up _____

Drilling and Remarks:

*Lease 2911**5" @ 2912**No shows***RECORD**

Cased _____ in., _____ ft.

Sand _____

Gas _____

Oil _____

Total Depth 2968**PRODUCTION**

1st 24 hrs. Nat. _____

1st 24 hrs. after shot _____

Gas _____ Cu. Ft.

Dry Hole _____

Abandoned _____

Date

JUN 5 1940 19

S. J. LEWIS

Scout