


Ellis

KANSAS

SECTION 19 TOWNSHIP 13 RANGE 20W

WELL NO. #1 Augustine

COMPANY Coppinger Drlg

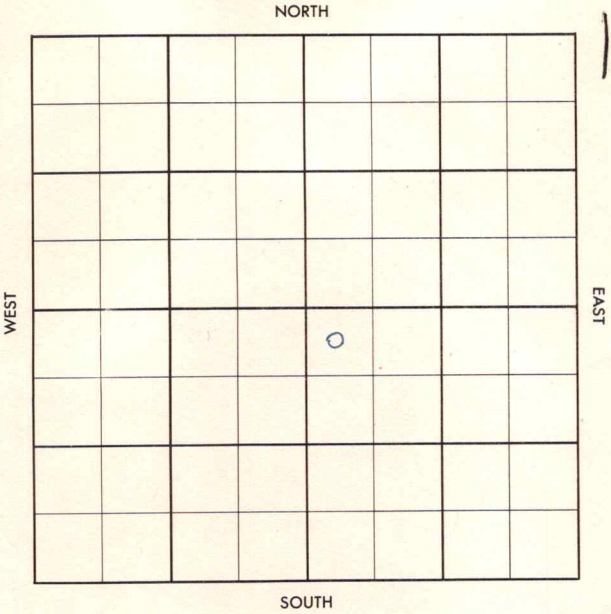

SEC. 19	TWP. 13	R. 20W
------------	------------	-----------

WELL NO. #1 Augustine FARM

COMPANY

CONTRACTOR Coppinger Drlg.

Co. Tools


WILDCAT

_____ Ft. from N. Line

_____ Ft. from S. Line

_____ Ft. from E. Line

_____ Ft. from W. Line

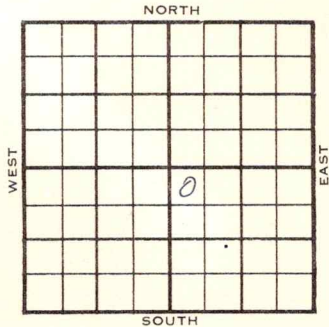

NW NW SE

Stanolind, Skelly & Gulf -DHM

1956	ELEVATION 2254'	REPORT
------	--------------------	--------

4-25 8" @ 216 w/125
Drlg. 1650
Anh. 1585

5-9 DST 3890-3900 op 1 hr. rec. 30' OCM,
BHP 700/20".
D & A
H. 3526', L. 3564', C. 3867', A. 3966'
TD 4016'

ABANDONED

520957

County Ellis Elev. _____
 Sec. 19 Twp. 13 Rge. 20W
 Company Coppinger Drlg.
 FarmName Augustine No. 1

TOPS	DEPTH	LOG	DATUM	Loc. in Sec.
Anh.	1585			NW NW SE
TP.				
H.				
Tr.				
Dg.				
Bl.				
L.				Geol. _____
K.C.				Contr. _____
B.K.C.				
Ce.				Co. tools
C.				
M.				Pool
M.				Wildcat
K.				
Mz.				
Me.				
V.				
S.				
S.				
A.				
R.				
PE.				
G.				
T.D.				

FIRST REPORT
 APR 25 '56

Date Comm. Stanolind, Skelly & Gulf - DHM
8" @ 216/125 drlg. 1650

MAY 5 1956

R.G.

Co.
 Lse.
 No.
 Sec.
 T.
 R.