

Section 21 Township 13 Range 20 W

Well No. # 1 Herman "B"

Company Imperial Oil

NORTH

						0	

9

WEST

EAST

SOUTH

Sec. 21 Twp. 13 R. 20W

Well No. #1 Herman "B" Farm

Imperial Oil Company


Imperial Wildcat Contractor

330 Ft. from N. Line

Ft. from S. Line

990 Ft. from E. Line

Ft. from W. Line

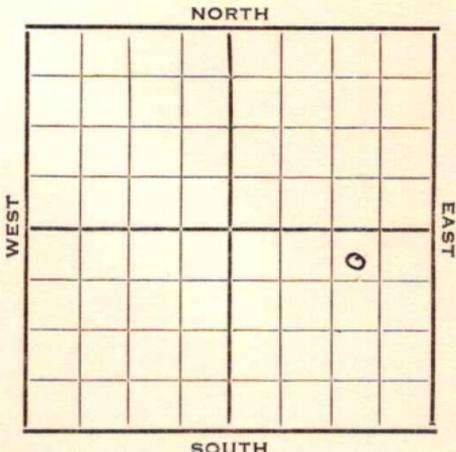

NW NE SE

1952

Elev. 2225' REPORT

7/30
8/6

Location
8" @ 180'
Anhy 1558'
Drlg. 2093'

8/13

Heeb. 3471 Tor 3489
Lans. 3509
DST 3520-15, 1/4 hr. 1240' SW
1110# DST 3580-98, 2 hrs. 130'm
& SW 1120# SSO 3610-15, 3662-26
3646-57, 3668-72 3668-96
DST 3686-96, 12 mins. 12'm
1030# Drlg. 3820'

8/20

Spud 8-2-52 D&A TD 3942
8" @ 180 Anhy 1558 Heeb. 3471
Tor. 3489 Lans. 3509
DST 3520-51 opn 1/4 hr. Rec. 1240' sw
1110# DST 3580-98 opn 2 hr. Rec. 130'
mud & sw 1120# SO 3610-15, 3622-26,
3646-57, 3668-72, 3688-96
DST 3686-96 opn 12 min. Rec. 12' mud
1030# Cong. 3878 VSSO 3814-19
Arb. 3883 DST 3884-95 opn 1 hr.
Rec. 55' mud 400# TD 3942 D&A

ABANDONED

County Ellis State Kansas

Sec. 21 (Blk. 13) (Sur. 20W) (Twp.) (Rge.) Map No.

Operator Imperial Oil

Well No. 1 Farm Herman "B"

Elev. Location NW NE SE

FIRST REPORT

330 Ft. From N Line SE

990 Ft. From E Line Quarter

Ist. Report JUL 30 1952

Completion

Remarks

Imperial - Contr.

Spudding Date

Drig. Data Wildcat

Location

County Ellis State KANSAS

Sec. 21 (Blk. Twp.) 13 (Sur. Rge.) 20W Map No.

Operator Imperial Oil

Well No. 1 Farm Herman "B"

Elev. 2225 Location NW NE SE



330 Ft. From N Line SE

990 Ft. From E Line Quarter

1st. Report

Completion AUG 20 1952

Remarks Wildcat
Imperial - Contr.

Spudding Date 8-2-52

Drig. Data D & A TD 3942

8" @ 180 Anhy 1558 Heeb. 3471

Tor. 3489 Lans. 3509 DST 3520-51

open 1/4 hr. Rec. 1240' sw 1110#

DST 3580-98 open 2 hr. Rec. 130' mud

& sw 1120# SO 3610-15 3622-26

3646-57 3668-72 3688-96 DST 3686-96

open 12 min. Rec. 12' mud 1030#

Cong. 3878 VSSO 3814-19 Arb. 3883

DST 3884-95 open 1 hr. Rec. 55' mud

400# TD 3942

D & A

J. G. McGEHEE