


Section 22 Township 14 Range 19W

Well No. 1 Kraus <sup>C</sup>~~11B~~

Company W.C. McBride

Kraus Pool

NORTH

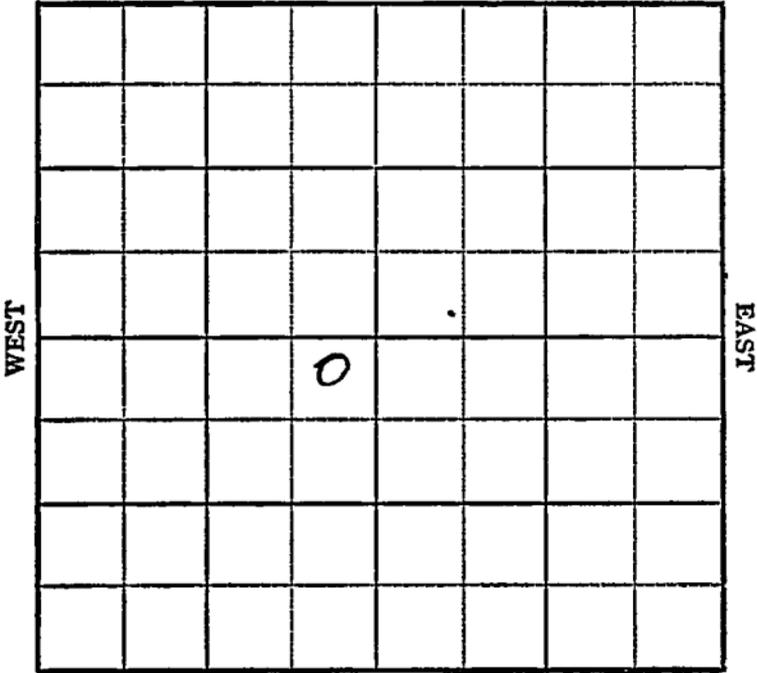

SOUTH

Sec. 22 Twp. 14 R. 19-W

Well No. #1 ~~#3~~ Kraus "8" "C" Farm

W G McBride Company  
Kraus


330 Ft. from N. Line

\_\_\_\_\_ Ft. from S. Line

330 Ft. from E. Line

\_\_\_\_\_ Ft. from W. Line

NE SW

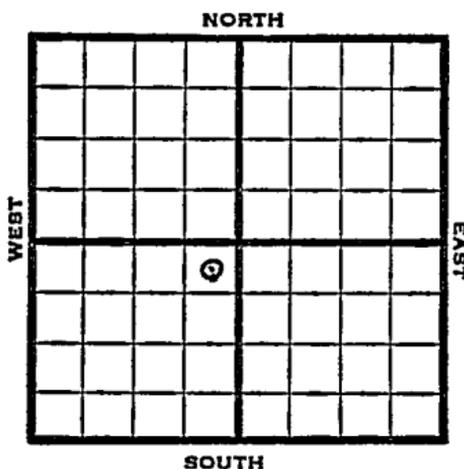

1948

Elev. 2128' REPORT

9/29

8" @ 276  
Drlg 300'

10/6

Drlg 2290'

10/13

Lansing 3442'  
Arb. 3727' ?  
TD 3740'  
Run 5"

10/19

5" @ 3731'

10/26

TD 3759'  
500 acid

11/3

"

11/10

Swb 30 bbls oil - 12 hrs.

11/17

Arb. 3727'  
5" @ 3731'  
500 acid  
Pump 50 oil Pot.  
Gr. 29  
TD 3759'

**COMPLETED**

Map No. 70 Sec. 22 Twp. 14 R. 19W

Well No. 1 Kraus "C"

W. C. McBride Company

COMPLETE Contractor

NE SW

*E/2/28*  
SECTION PLAT

330 Ft. from N. Line

\_\_\_\_\_ Ft. from S. Line

330 Ft. from E. Line

\_\_\_\_\_ Ft. from W. Line


Ellis County

Location \_\_\_\_\_

Rig up \_\_\_\_\_

Drilling and Remarks:

*Art 2727*  
*5" 3373/*  
*500 acid*  
*Pump 50 oil bot.*  
*29-3/4*

RECORD

Cased \_\_\_\_\_ in., \_\_\_\_\_ ft.

Sand \_\_\_\_\_

Gas \_\_\_\_\_

Oil

Total Depth 3257

PRODUCTION

1st 24 hrs. Nat. \_\_\_\_\_

1st 24 hrs. after shot \_\_\_\_\_

Gas \_\_\_\_\_ Cu. Ft.

Dry Hole \_\_\_\_\_

Abandoned \_\_\_\_\_

Date

NOV 17 1948 19

S. J. LEWIS Scout

Map No. \_\_\_\_\_ Sec. 22 Twp. 14 R. 19W

Well No. 1 Kraus "C"

W. C. McBride \_\_\_\_\_ Company

CORRECTION \_\_\_\_\_ Contractor

NE SW

SECTION PLAT

330 \_\_\_\_\_ Ft. from N. Line

\_\_\_\_\_ Ft. from S. Line

330 \_\_\_\_\_ Ft. from E. Line

\_\_\_\_\_ Ft. from W. Line


Ellis County

Location \_\_\_\_\_

Rig up \_\_\_\_\_

Drilling and Remarks:

Reported as  
#3 Kraus "B"

RECORD

Cased \_\_\_\_\_ in., \_\_\_\_\_ ft.

Sand \_\_\_\_\_

Gas \_\_\_\_\_

Oil \_\_\_\_\_

Total Depth \_\_\_\_\_

PRODUCTION

1st 24 hrs. Nat. \_\_\_\_\_

1st 24 hrs. after shot \_\_\_\_\_

Gas \_\_\_\_\_ Cu. Ft.

Dry Hole \_\_\_\_\_

Abandoned \_\_\_\_\_

Date

NOV 17 1948 19 \_\_\_\_\_

S. J. LEWIS Scout

Map No. \_\_\_\_\_ Sec. 22 Twp. 14 R. 19W

Well No. 3 Kraus "B"

W. C. McBride Company

FIRST REPORT

Contractor

NE SW

SECTION PLAT

330 Ft. from N. Line

\_\_\_\_\_ Ft. from S. Line

330 Ft. from E. Line

\_\_\_\_\_ Ft. from W. Line

	o		

Ellis County

Location \_\_\_\_\_

Rig up \_\_\_\_\_

Drilling and Remarks:

8" @ 276

drlg. 300

RECORD

Cased \_\_\_\_\_ in., \_\_\_\_\_ ft.

Sand \_\_\_\_\_

Gas \_\_\_\_\_

Oil \_\_\_\_\_

Total Depth \_\_\_\_\_

PRODUCTION

1st 24 hrs. Nat. \_\_\_\_\_

1st 24 hrs. after shot \_\_\_\_\_

Gas \_\_\_\_\_ Cu. Ft.

Dry Hole \_\_\_\_\_

Abandoned \_\_\_\_\_

Date

SEP 29 1948 19

S. J. LEWIS, Scout