


Section 22 Township 14 Range 19W

Well No. 2 Kraus

Company ~~Coppinger & Southern~~ W.C. McBride, Inc.

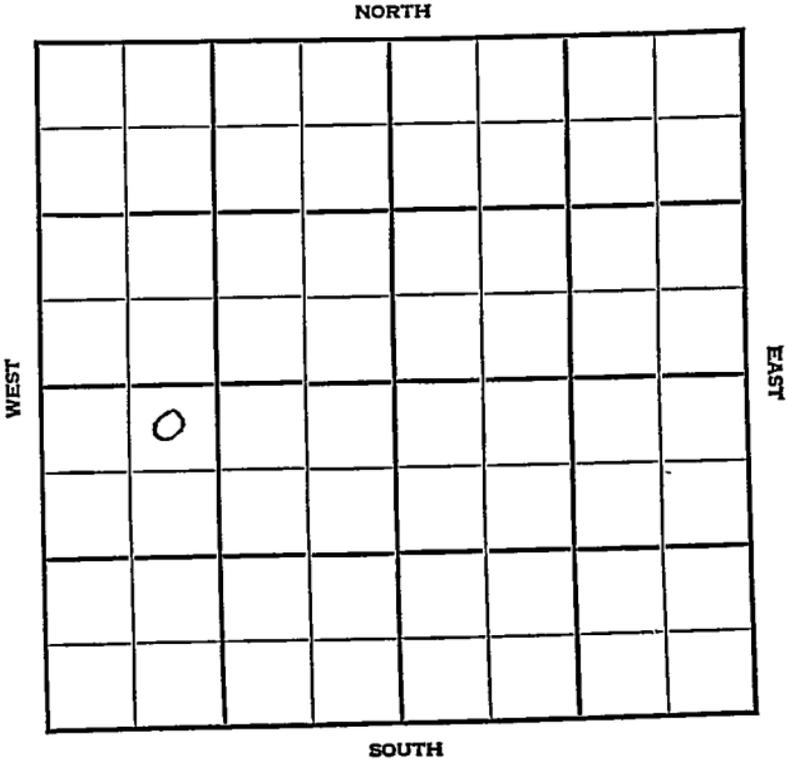

Sec. 22 Twp. 14 R. 19-W

Well No. #2 Kraus Farm

W. C. McBride
~~Coppinger & Southern~~ Company

Kraus

NORTH


330 Ft. from N. Line

_____ Ft. from S. Line

_____ Ft. from E. Line

990 Ft. from W. Line

NE NW SW

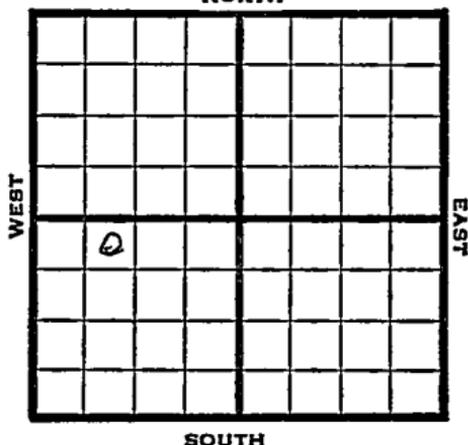

1948 Elev. 2118' REPORT

8/11 8" @ 264'
Anhy 1440'
Arb. 3728'
TD 3746'
5" @ 3729'

8/18 TD 3748'
Swb 4 bbls oil PH 500 acid

8/25 Swb 7 bbls oil PH

9/1 Pump 52 bbls oil a day

9/8 "

9/14 "

9/21 "

9/29 "

10/6 Arbuckle 3728'
5" @ 3729'
500 acid
Pump 80 oil Pot.
Gr. 29°
TD 3748'

COMPLETED

Ellis County Kansas State

Map No. _____ Sec. 22 Twp. 14 R. 19W

Well No. 2 Kraus

Coppinger & Southern Company

FIRST REPORT Contractor

NE NW SW

SECTION PLAT

330 Ft. from N. Line

_____ Ft. from S. Line

_____ Ft. from E. Line

990 Ft. from W. Line

| | | | | | | | |
|--|--|--|--|--|--|--|--|
| | | | | | | | |
| | | | | | | | |
Kraus Pool

Remarks:

8" @ 264 Anhy 1440 Arb. 3728

TD 3746 5" @ 3729

Date AUG 11 1948

Scout S. J. LEWIS

Map No. 70 Sec. 22 Twp. 14 R. 19W

Well No. 2 Kraus "B"

W. C. McBride Inc. Company

COMPLETE Contractor

NE NW SW

E 1218
SECTION PLAT

330 Ft. from N. Line

_____ Ft. from S. Line

_____ Ft. from E. Line

990 Ft. from W. Line

| | | | |
|---|--|--|--|
| | | | |
| | | | |
| o | | | |
| | | | |

Ellis County

Location _____

Rig up _____

Drilling and Remarks:

Ac 43728
5" @ 3729
500 acial
Pump. Soil Box

29-8

RECORD

Cased _____ in., _____ ft.

Sand _____

Gas _____

Oil _____

Total Depth 3747

PRODUCTION

1st 24' hrs. Nat. _____

1st 24 hrs. after shot _____

Gas _____ Cu. Ft.

Dry Hole _____

Abandoned _____

Date

OCT 6 1948 19__

S. J. LEWIS Scout

