


Section 36 Township 14 Range 19W

Well No. #1 ~~Bofort~~ Schwaller KGS DRL

Company Peel-Hardman

NORTH

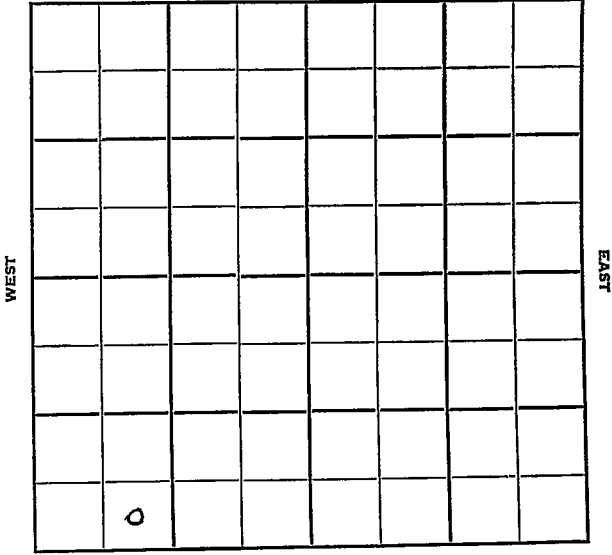

SOUTH

WEST

EAST

Ellis

KANSAS 19W

Sec. 36 Twp. 14 R. _____

Well No. #1 Befort Farm _____

Peel-Hardman Company _____

Contractor _____


_____ Ft. from N. Line

330' Ft. from S. Line

_____ Ft. from E. Line

850' Ft. from W. Line

SE SW SW

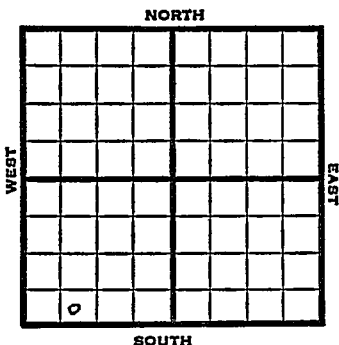

1951 Elev. 2099' REPORT

4/18 Spud 4-14-51
8" @ 160
Drlg. 1155'

7/11 Spud 4-14-51
Oil Well TD 3704
8" @ 160
Arb. 3689-91
5" @ 3690 TD 3697
500 A DD 3704
6 goph 750 A 15 boph
3 1/4 bwph P/30 bopd
Comp. 50 bopd 35% wtr.

CONFIDENTIAL

