


KANSAS

DX 78-1 ELLIS

Section 21 Township 13 Range 20W

Well No. 1 Schumacher

Company VICTOR Drlg.

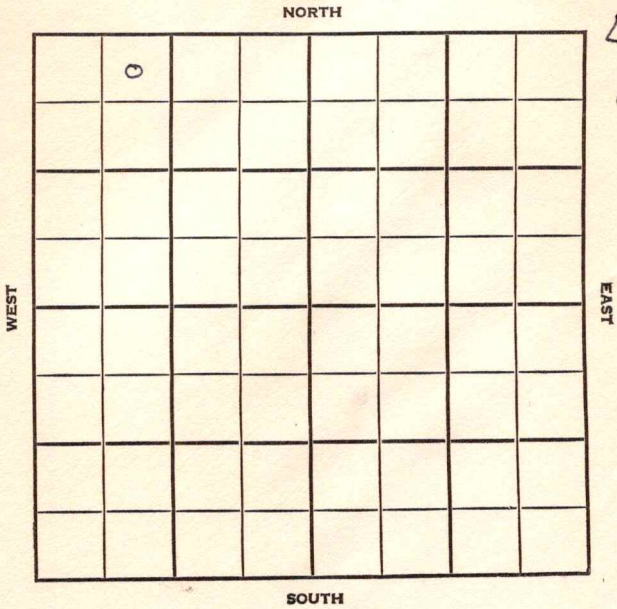

KANSAS

SEC.	TWP.	R.
21	13	20 W

WELL NO. _____

1 Schumacher

FARM

COMPANY

Victor Drlg.

CONTRACTOR

Co. tools

E. Rahnesford Pool

330

Ft. from N. Line

Ft. from S. Line

Ft. from E. Line

Ft. from W. Line

NE NW NW

NORTH

WEST

EAST

SOUTH

1955

ELEVATION

2206:

REPORT

3/30

Spud 3-20-55

8" @ 187 Top 3216 Heeb 3469

KC 3509 Arb. 3873

DST 3872-3900, open 1 hr rec 135'

mud. TD 3920'

4/6

Spud 3-20-55, D&A, TD 3920

8th @ 187, Top 3216, Heeb 3469,

KC 3509, Arb 3873, DST 3872-

3900 open 1 hr Rec 135' mud

TD 3920

D&A

ABANDONED

County Ellis State KansasSec. 21 (Blk.) 13 (Sur.) 20W Map No.Operator Victor Drlg.Well No. 1 Farm SchumacherElev. Location NE NW NW

2					

330 Ft. From N Line NW990 Ft. From W Line Quarter1st. Report MAR 30 1955

Completion

Remarks

Co. toolsSpudding Date 3-20-55Drlg. Data E. Raynesford Pool8" @ 187 Top. 3216 Heeb. 3469KC 3509 Arb. 3873 DST 3872-3900open 1 hr. Rec. 135' mud TD 3920

FABEN GILSTRA

County Ellis State KansasSec. 21 (Blk.
Twp.) 13 (Sur.
Rge.) 20W Map No.Operator Victor Drlg.Well No. 1 Farm SchumacherElev. 2206 Location NE NW NW

0					

330 Ft. From N Line NW990 Ft. From W Line Quarter

1st. Report

Completion APR 6 1955Remarks E. Raynesford PoolCo. toolsSpudding Date 3-20-55Drlg. Data D & A TD 39208" @ 187 Top. 3216 Heeb. 3469KC 3509 Arb. 3873 DST 3872-3900open 1 hr. Rec. 135' mud TD 3920D & A

FABEN GILSTRAP