

Ellis

KANSAS

29


14S

19W

SECTION _____ TOWNSHIP _____ RANGE _____

WELL NO. #1 Wilson

COMPANY Martin Oil Co.

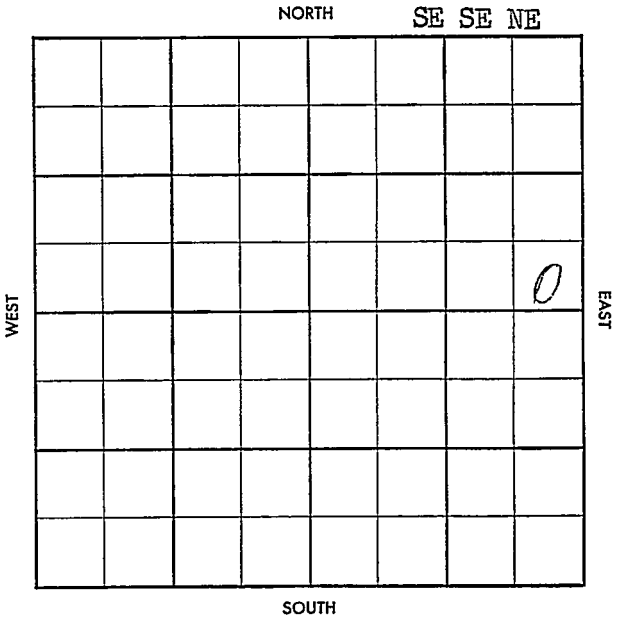

S-513-A

~~Kraus~~




COMPANY Martin Oil Co. NO 7

ABANDONED

FARM Wilson


GEOL. _____

CONTR Illinois

POOL Wilson

SPUD 11-20-57

8" 220/125

Anh 1393 Ø 3010

DEC 4 '57 TP 3120

H6 3388 TR3409

Lsg 3431 DST

3470-90 30" 1.5' M NS BHPD

Anh 3765 RTD 3785' NS

no log

DBA.

CO

LSE

NO. SEC.

TWP.

RGE.