


Section 28 Township 14 Range 19 W

Well No. # 1 Weber

Company Stewart Bailey

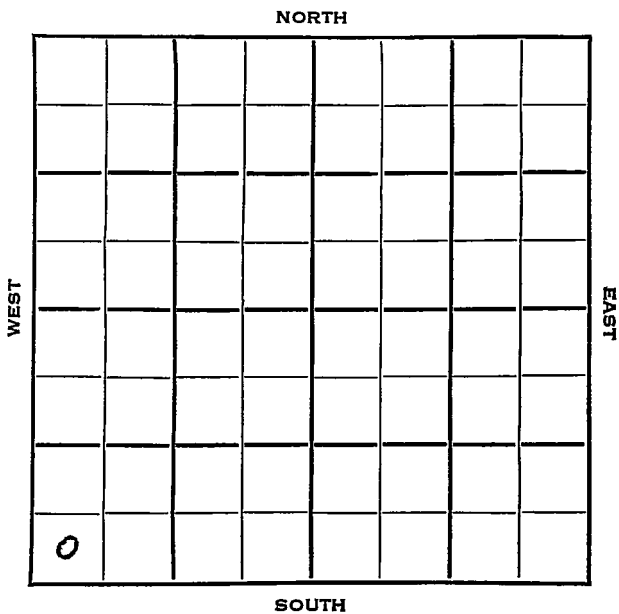

Ellis

SEC.	TWP.	R.
28	14	19 W ✓

WELL NO.

# 1 Weber

FARM

COMPANY

Stewart Bailey

CONTRACTOR

Scharffer

Wildcat


\_\_\_\_\_ Ft. from N. Line

330

\_\_\_\_\_ Ft. from S. Line

\_\_\_\_\_ Ft. from E. Line

330 \_\_\_\_\_ Ft. from W. Line

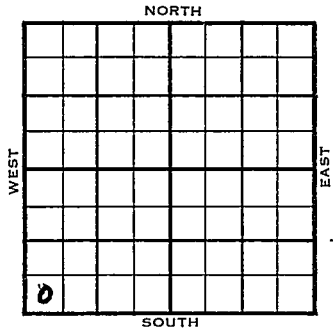

SW SW SW

CSO - support

	ELEVATION	REPORT
1953	2113'	
9/30	Spud 9-22-53 8" @ 192' Anhy 1380' Drlg. 3300'	
10/7	Heeb 3369' Dodge 3390' Lans 3415 Cong 3710' Arb. 3734 DST 3736-39' open 1/2 hr, 8' M 930# DST 35738-44, 1 1/2 hr, 62' MCO, 30' SOCM 985# RTD 3744' 5" @ 3736'	
10/14	Spud 9-22-53 D&A TD 3744' 8" @ 192' Anhy 1380', Heeb 3369', Dodge 3390', ans 3415, Cong 3710', Arb. 3734' DST 3736-39, opn 1/2 hrs., rec. 8' mud, 930# DST 3738-44, opn 1 1/2 hrs., rec. 62' mco, 30' SOCM, 985# TD 3744' 5" @ 3736 CO to 3744 S/1/2 boph, 500A, S/8 boph, S/60 bo 30 bw 8 hrs. S/30 bo 67 bw 14 hrs., S/6 bo 130 bw 24 hrs. D&A	



