


Section 23 Township 14 Range 20-W

Well No. 1 Hazelhorst

Company H. H. & B. & Phillips

Wildcat

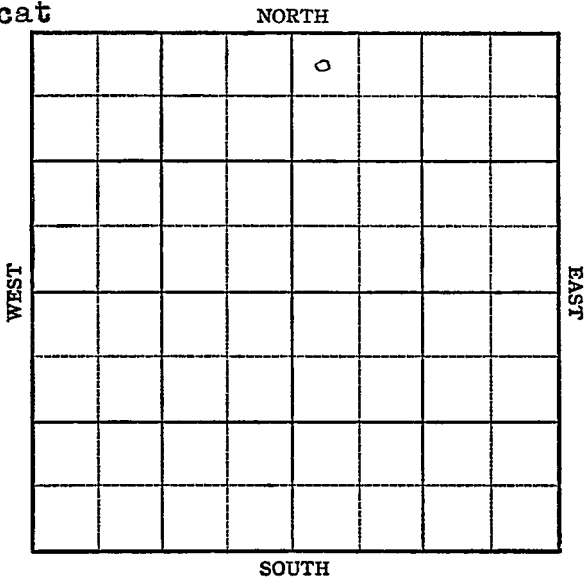

KANSAS Ellis

Sec. 23 Twp. 14 R. 20W

Well No. #1 Hazelhorst Farm

H. H. & B. & Phillips Company

Wildcat


330 Ft. from N. Line

 Ft. from S. Line

 Ft. from E. Line

330 Ft. from W. Line

NW NE

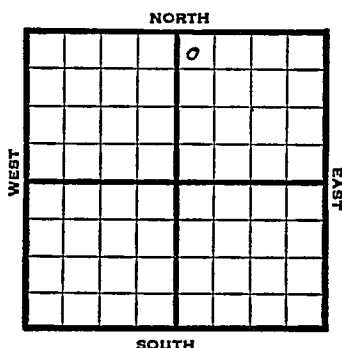

1947

Elev. 2136 REPORT

9/17 10" @ 133'
Drlg. 2200'

9/24 Lansing 3432'
Drlg. 3538'

10/1 Arbuckle 3772
Reagan 3799
Quartzite 3804
TD 3805
E **ABANDONED**


Map No. 70 Sec. 23 Twp. 14 R. 20WWell No. 1 HazelhorstH. H. & B. & Phillips Company

FIRST REPORT

Contractor

NW NE

SECTION PLAT

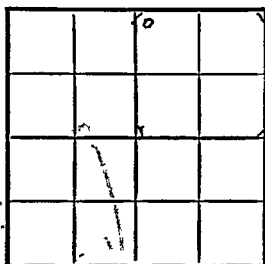330 Ft. from N. Line Ft. from S. Line Ft. from E. Line330 Ft. from W. Line

Ellis County

Location Rig up

Drilling and Remarks:

10" @ 133

drlg. 2200

RECORD

Cased in, ft.Sand Gas Oil Total Depth

PRODUCTION

1st 24 hrs. Nat. 1st 24 hrs. after shot Gas Cu. Ft.Dry Hole Abandoned

Date

SEP 17 1947 19 S. J. LEWIS Scout

Map No. 70 Sec. 23 Twp. 14 R. 20W

Well No. 1 Hazelhurst

H. H. & B. & Phillips Company

ABANDONED

Contractor

NW NE

E. 12/86

SECTION PLAT

330 Ft. from N. Line

 Ft. from S. Line

 Ft. from E. Line

330 Ft. from W. Line

		6	

Ellis County

Location

Rig up

Drilling and Remarks:

*Art 3772
Reagan 2799
Dwight 2804*

RECORD

Cased in., ft.

Sand

Gas

Oil

Total Depth 3825

PRODUCTION

1st 24 hrs. Nat.

1st 24 hrs. after shot

Gas Cu. Ft.

Dry Hole

Abandoned

Date

OCT 1 1947

19

S. J. LEWIS Scout