

Ellis

KANSAS


DX 78-1

Section 22 Township 14 Range 20W

Well No. #1 Solomon "B"

Company Shields Oil Prod.

NORTH

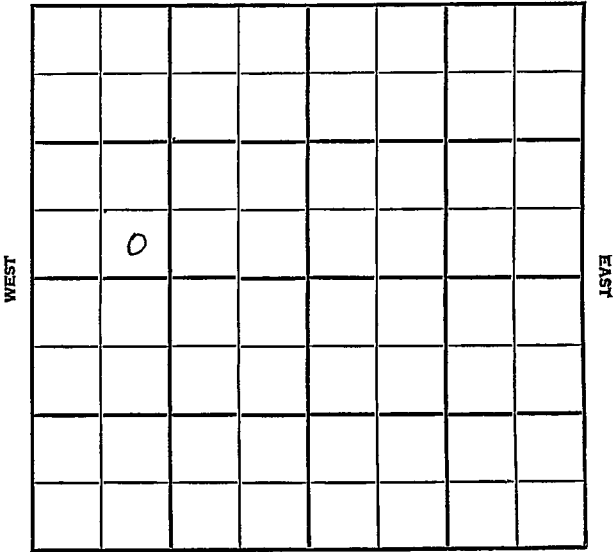

SOUTH

County K1 Wis Elev. _____
 Sec. 22 Twp. 14 Rge. 20W
 Company Shields Oil Prod.
 FarmName Solomon "B" No. 1

TOPS	DEPTH	LOG	DATUM	Loc. in Sec.
Anh.				SE SW NW
TP.				
H.				
Tr.				
Dg.				
BL.				
L.				Geol. _____
K.C.				Contr. _____
B.K.C.				Co. Tools _____
Ce.				
C.				Pool _____
M.				
M.				
K.				
Mz.				
Me.				
V.				
S.				
S.				
A.				
R.				
PE.				
G.				
T.D.				

DEC 5 1931

FIRST REPORT

Date Comm. _____
 Location _____

~~14~~

Co.
Lse.
No.
Sec.
T.
R.

County Ellis Elev. 2231
 Sec. 22 Twp. 14 Rge. 20W
 Company Shields Oil Prod.
 FarmName Salomon "B" No. 1

Co.

TOPS	DEPTH	LOG	DATUM
Anh	735		
TP			
H.	3476		
Tr.	3498		
Dg.			
Bl.			
L.	3515		
K.C.			
B.K.C.			
Ce. <u>Marm</u>	3813		
C.	3854		
M. <u>09 50</u>	3860		
M.			
K.			
Mz.			
Mo.			
V.			
S.			
A.			
R. <u>50</u>	3877		
PT SITE	3885		
G.			
TD.	3886		

Loc. in Sec. SE SW N4
 Geol. _____
 Contr. _____
 Co. Tools _____
 Pool _____

Use.

ABANDONED
 of
 JAN 2 '57

No.

Date Comm. Mag F.O.
 Location DEC 12 '55 12-8-56 85/8
270 292 DEC 19 '55 3616
DEC 26 '55 DIST 3829-86 30" rec
510' SW BHP 1150/15" JAN 2 '57

Sec.

T.

D&A

R.