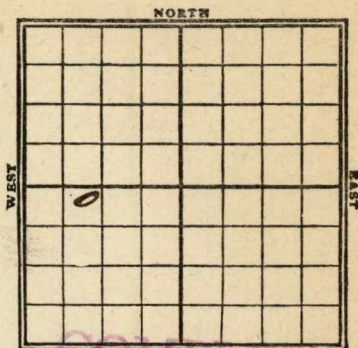


Map No. K Sec. 13 Twp. 29 R. 5Well No. 5 Noblen FarmMagna Oil Company330 Ft. from N. Line

Ft. from S. Line

Ft. from E. Line

990 Ft. from W. Line

Date

REPORT REPORT

4/8	Timbers
6/14	-
7/11	200
8/4	Drq @ 1300'
8/4	2300'
8/10	D.lg @ 2500'
8/29	5" @ 2767'
9/1	2819-32. 30 ffls.

Map No. K11 Sec. 13 Twp. 29 R. 5Well No. 5 MadenMagna Oil Company

Contractor

SECTION PLAT

330 Ft. from N. Line

Ft. from S. Line

Ft. from E. Line

990 Ft. from W. Line

COMPLETED

Location

Rig up

Drilling and Remarks:

RECORD

Cased _____ in., _____ ft.

Sand 2819 - 32

Gas _____

Oil _____

Total Depth _____

PRODUCTION

1st 24 hrs. Nat. 30 bbls

1st 24 hrs. after shot _____

Gas _____ Cu. Ft.

Dry Hole _____

Abandoned _____

Date

9/1 191 20 Pyle Scout