


Section 14 Township 29 Range 5EWell No. #1 Adams - DoyleCompany Aladdin Pet.

NORTH

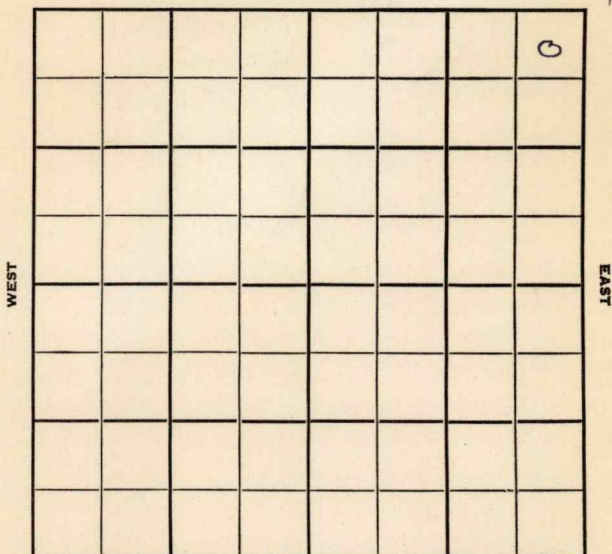

SOUTH

Butler

KANSAS

Sec. 14 Twp. 29 R. 5E

Well No. #1 Adams-Doyle Farm

Aladdin Pet.

Company

Morrison - Contr.

Contractor


269' Ft. from N. Line

Ft. from S. Line

91' Ft. from E. Line

Ft. from W. Line

NE NE NE

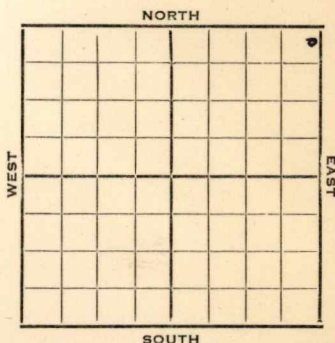

1952 Elev. 1361' REPORT

4/9 RUR

4/30 Spud 4-7-52
D&A TD 2822' 8" @ 90'
Bart 2785 5" @ 2796
TD 2822' D&A

ABANDONED

