




*Cowley*

Map No. KANSAS Sec. 9 Twp. 34 R. 3E

Well No. 1 Wycoff Farm \_\_\_\_\_  
Ben Hollop Company \_\_\_\_\_

\_\_\_\_\_ Ft. from N. Line  
330 Ft. from S. Line  
\_\_\_\_\_ Ft. from E. Line  
330 Ft. from W. Line

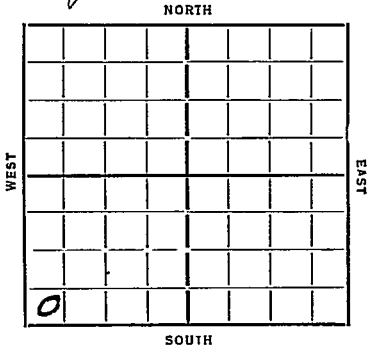

Date	REPORT
<u>1934</u>	
<u>11/14</u>	<u>Cellar</u>
<u>11/22</u>	<u>— 11/28 —</u>
<u>12/6</u>	<u>Machine</u>
<u>12/13</u>	<u>Rign</u>
<u>12/21</u>	<u>— 12/27 —</u>
<u>1/3/35</u>	<u>Spud</u>
<u>1/19</u>	<u>Dlg 451</u>
<u>1/17</u>	<u>id 1175</u>
<u>1/24</u>	<u>SD 1900</u>
<u>1/30</u>	<u>TD 1952 D r A</u>

**ABANDONED**

Map No. 1 Sec. 9 Twp. 34 R. 3E

Well No. 1 - Wycoff

Ben Krollop Company  
Contractor

**FIRST REPORTS**

**SECTION PLAT**

\_\_\_\_\_ Ft. from N. Line

330 Ft. from S. Line

\_\_\_\_\_ Ft. from E. Line

330 Ft. from W. Line


Location \_\_\_\_\_

Rig up \_\_\_\_\_

Drilling and Remarks:

*cellar*

**RECORD**

Cased \_\_\_\_\_ in., \_\_\_\_\_ ft.

Sand \_\_\_\_\_

Gas \_\_\_\_\_

Oil \_\_\_\_\_

Total Depth \_\_\_\_\_

**PRODUCTION**

1st 24 hrs. Nat. \_\_\_\_\_

1st 24 hrs. after shot \_\_\_\_\_

Gas \_\_\_\_\_ Cu. Ft.

Dry Hole \_\_\_\_\_

Abandoned \_\_\_\_\_

Date

11-14-34 19

**CARVAL MANNSCHRECK**

Scout

Map No. 1 Sec. 9 Twp. 34 R. 3E

Well No. 1-Mycroft

Ben Krallop Company

Contractor

**ABANDONED**

**SECTION PLAT**

..... Ft. from N. Line

330 Ft. from S. Line

..... Ft. from E. Line

330 Ft. from W. Line

0			

Location.....

Rig up.....

Drilling and Remarks:

U + A

**RECORD**

Cased..... in., ..... ft.

Sand.....

Gas.....

Oil.....

Total Depth. 1952

**PRODUCTION**

1st 24 hrs. Nat.....

1st 24 hrs. after shot.....

Gas..... Cu. Ft.

Dry Hole.....

Abandoned.....

Date

1-30-35 192.....

**ORVAL MANNSCHRECK**

Scout