


KANSAS

Section 9 Township 34 Range 3E

Well No. #3 Rogers

Company Stelbar

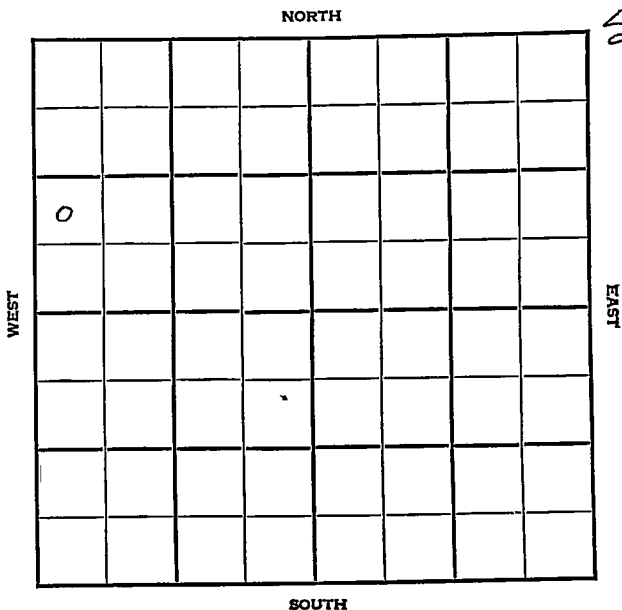

KANSAS

Cowley

✓

Sec. 9 Twp. 34 R. 3-E

Well No. #3 Rogers Farm

Stelbar Company


Miscellaneous

_____ Ft. from N. Line

990' Ft. from S. Line

_____ Ft. from E. Line

330' Ft. from W. Line

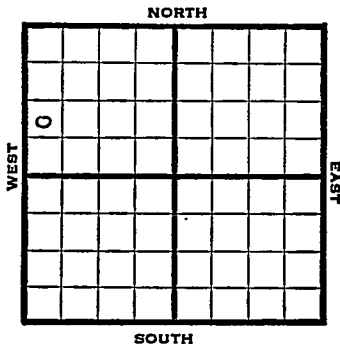

NW SW NW

1947	Elev. 1085' REPORT
11/25	Location
12/3	10" @ 100' Drlg. 1450'
12/10	Drlg. 3131'
12/17	KC 2789' Mississippi 3297' TD 3302' 7" @ 3302' RUST
12/30	Drlg. 3329'
1948	"
1/7	"
1/14	Miss. 3297' 7" @ 3302' Pump 60 Pot 39.0 Gr. TD3329' Comp.
COMPLETED	

Map No. _____ Sec. 9 Twp. 34 R. 3E

Well No. 3 Rogers

Stelbar Company

FIRST REPORT Contractor

NW SW NW

SECTION PLAT

_____ Ft. from N. Line

990 Ft. from S. Line

_____ Ft. from E. Line

330 Ft. from W. Line

o			

Cowley County

Location X

Rig up _____

Drilling and Remarks:

RECORD

Cased _____ in., _____ ft.

Sand _____

Gas _____

Oil _____

Total Depth _____

PRODUCTION

1st 24 hrs. Nat. _____

1st 24 hrs. after shot _____

Gas _____ Cu. Ft.

Dry Hole _____

Abandoned _____

Date

NOV 25 1947

19

S. J. LEWIS

Scout

