

KANSAS


Cowley

O.W.W.O.

Section 10 Township 34 Range 3-E

Well No. #1 R. W. Beeks

Company ~~B. E. Blair~~
ALADDIN

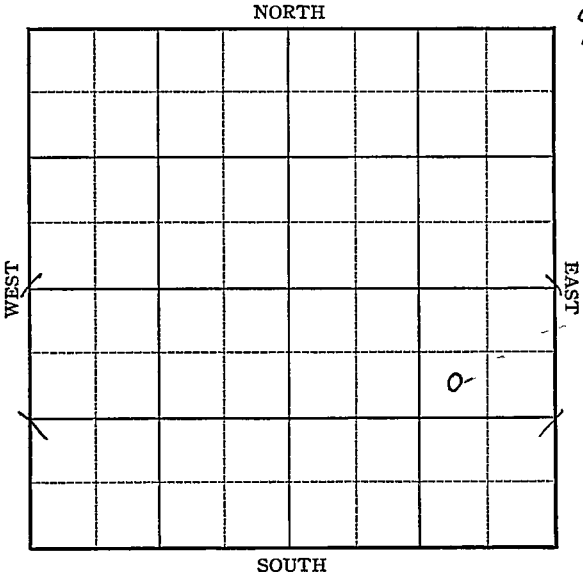

KANSAS

Cowley **O.W.W.O.**

Sec. 10 Twp. 34 R. 3-E

Well No. 11 R. W. Becks Farm

AKADDIN

~~B. B. Blair~~ Company

~~W. B. Blair~~ **Crowe Drilling Co.**


Miscellaneous
HARVEY POOL

990 Ft. from N. Line

_____ Ft. from S. Line

990 Ft. from E. Line

_____ Ft. from W. Line

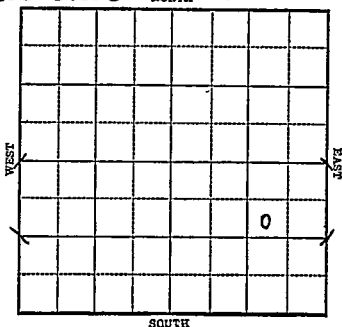

SW NE SE Elev. 1155

1943

Elev. 1155' REPORT

7/7 Location.

7/15 "

7/21 585' Run csg

7/28 15" @ 640'
12" @ 1350'
Drlg. 1505'

8/4 10" @ 1505'
Drlg. 1625'

8/11 1924' UR 10"

8/18 10" @ 1924'
2345 UR 8"

8/25 8" @ 2357
Lans 2630
7" @ 2630
Drlg. 2639'

9/1 KC 2839
Drlg. 3045

9/8 Miss 3374
T.D. 3403

ABANDONED

OVER

O.W.W.O.

#1 Beeks

1953
4/29

Lans 2630, Layton 2648, KC 2839,
Miss 3374
OTD 3403
To Work Over

6/10

D & A TD 3391 Lans 2630
Layton 2648 KC 2839 Miss 3374
OTD 3403 GO to 3391 5" @ 3390
23/3329-33 18/3342-45 Sd-frac.
D & A

ABANDONED

KANSAS

Map No. / Sec. **10** Twp. **34** R. **3E**

Well No. **1 R. W. Becks**

B. B. Blair Company

FIRST REPORT

Contractor

SW NE SE


SECTION PLAT

990 Ft. from N. Line

Ft. from S. Line

990 Ft. from E. Line

Ft. from W. Line

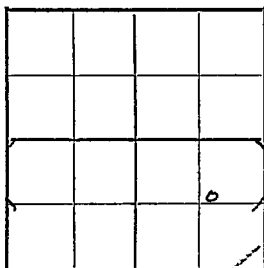

MISCELLANEOUS

Location **XXX**

Rig up

Drilling and Remarks:

RECORD

Cased _____ in., _____ ft.

Sand _____

Gas _____

Oil _____

Total Depth _____

PRODUCTION

1st 24 hrs. Nat. _____

1st 24 hrs. after shot _____

Gas _____ Cu. Ft.

Dry Hole _____

Abandoned _____

Date

JUL 7 1943 19

S. J. LEWIS Scout

Cowley

KANSAS

Map No. _____ Sec. 10 Twp. 34 R. 3E

Well No. 1 R. W. Becks

B. B. Blair Company

ABANDONED Contractor

SW NE SE

SECTION PLAT

990 Ft. from N. Line

_____ Ft. from S. Line

990 Ft. from E. Line

_____ Ft. from W. Line

MISCELLANEOUS*

Location _____

Rig up _____

Drilling and Remarks:

Miss 8374

RECORD

Cased _____ in., _____ ft.

Sand _____

Gas _____

Oil _____

Total Depth 3403

PRODUCTION

1st 24 hrs. Nat. _____

1st 24 hrs. after shot _____

Gas _____ Cu. Ft.

Dry Hole " _____

Abandoned _____

Date

SEP 8 1943 19

S. J. LEWIS Scout

