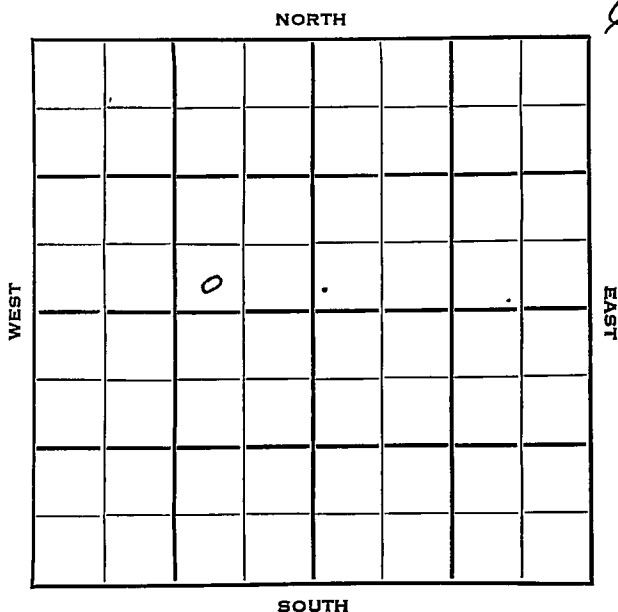


Cowley

KANSAS

Section 10 Township 34 Range 3EWell No. #1 ~~Kirkpatrick~~ LEWISCompany Russell Cobb

Cowley

KANSAS

✓

Sec. 10 Twp. 34 R. 3EWell No. ^{LEWIS}
#1 Kirkpatrick Farm

Russell Cobb

Company

Vickers Farmout

Contractor

Ft. from N. Line

330


Ft. from S. Line

990

Ft. from E. Line

Ft. from W. Line

SW SE NW

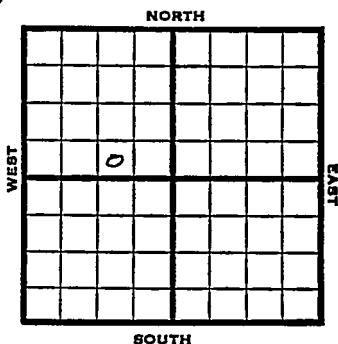

1950 Elev. 1146' REPORT

3/4 Location

6/3

Spud 3-15-53

Oil Well

TD 3375

8" @ 70

Bart 3321, Miss 3365,

TD 3375

5" @ 3375

102/3321-38, sd-frac

F/43 bo 1 hr., dec. to 9 boph

S/1½ boph

Comp. 2 bopd

COMPLETED

J. G. McGEHEE

Map No. _____ Sec. 10 Twp. 34 R. 3EWell No. 1 LewisRussell Cobb

Company

CORRECTION

Contractor

SW SE NW

SECTION PLAT

_____ Ft. from N. Line

330 Ft. from S. Line990 Ft. from E. Line

_____ Ft. from W. Line

Cowley County

Location _____

Rig up _____

Drilling and Remarks:

Reported
#1 Kirkpatrick

RECORD

Cased _____ in., _____ ft.

Sand _____

Gas _____

Oil _____

Total Depth _____

PRODUCTION

1st 24 hrs. Nat. _____

1st 24 hrs. after shot _____

Gas _____ Cu. Ft.

Dry Hole _____

Abandoned _____

Date

MAP 1 8 1953
19

J. G. McGEHEE Scout

J. G. McGEHEE